

Pearl River
W 207
1-27-77

MISSISSIPPI
 BOARD OF WATER COMMISSIONERS
 416 North State Street
 13V Jackson, Mississippi 39201

WATER WELL DRILLERS LOG

1-27 1977 Penton Well Serv Pearl River
 date well completed firm name county well located

LANDOWNER: Van Stockstill
Picayune MS
 (mailing address)

WELL LOCATION:
 Loc. 17 T 7 N R 18 E
S W
1 miles SW of Picayune
 (distance) (direction) (nearest town)

WELL PURPOSE: Home
 (home, irrigation, municipal, industrial)

- WELL COMPLETION DATA:
- (1) diameter (inches) 2
 - (2) total depth (feet) 1540
 - (3) static water level (feet) Flow ^{below} above top of ground.
 - (4) casing Galv 1520
 (material) (depth)
 - 2" If telescope see back.
 (size)
 - (5) screen 20' 1520
 (length) (depth to top)
 - 2 3 Steel
 (size) (material)
 - (6) pump _____ (HP) _____ (yield gpm)
 _____ (type power)
 - (7) electric log NO
 (yes or no)
 - _____ (organization running log)
 - (8) how well bottom plugged BW Valve

description of fomations encountered	from	to
Surface Clay	0	10
Sand	10	100
Blue Clay	100	330
Sand	330	460
Blue Clay	460	620
Sand	620	680
Blue Clay	680	770
Sand	770	900
Blue Clay	900	1110
Sand	1110	1140
Blue Clay	1140	1480
Sand	1480	1540

RECEIVED


MAR - 4 1977

DRILLERS REMARKS:

MISS. BD. OF WATER COMM.

If well telescopes please sketch and show depths.

GROUND LEVEL

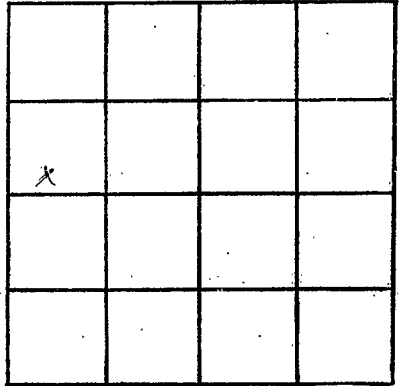

SECTION 17

Please indicate well location X.

ADDITIONAL INFORMATION

If more than one screen, show locations of each on sketch.