

Pearl River  
W 208  
7/21/76

MISSISSIPPI  
 BOARD OF WATER COMMISSIONERS  
 416 North State Street  
 Jackson, Mississippi 39201

WATER WELL DRILLERS LOG

July 21 1976 Lumpha Well Ser. P. R.  
 date well completed firm name county well located

LANDOWNER:

Mr. Melvin Hunt  
Picayune, Miss.  
 (mailing address)

description of formations encountered

from to

Clay	0	20
Sand	20	80
Clay	80	160
Sand	160	210
Clay	210	420
Sand	420	440
Clay	440	690
Sand	690	750
Clay	750	890
Sand	890	965

WELL LOCATION:

20

sec 17 T. 21 N. R. 17 E. W. West  
1.0 miles South of Picayune  
 (distance) (direction) (nearest town)

WELL PURPOSE:

Home  
 (home, irrigation, municipal, industrial)

WELL COMPLETION DATA:

- (1) diameter (inches) 2"
- (2) total depth (feet) 986'
- (3) static water level (feet) 5" below top of ground.
- (4) casing Gal. 965'  
 (material) (depth)
- 2" if telescope see back.  
 (size)
- (5) screen 21' 965'  
 (length) (depth to top)
- 2" Stainless Steel  
 (size) (material)
- (6) pump No. 416 P.M.  
 (HP) (yield gpm)
- No.  
 (type power)
- (7) electric log No.  
 (yes or no)

(organization running log)

(8) how well bottom plugged Sand

**RECEIVED**


OCT 26 1976

DRILLERS REMARKS:

MISS. BD. OF WATER COMMISSIONERS

If well telescopes please sketch and show depths.

GROUND LEVEL

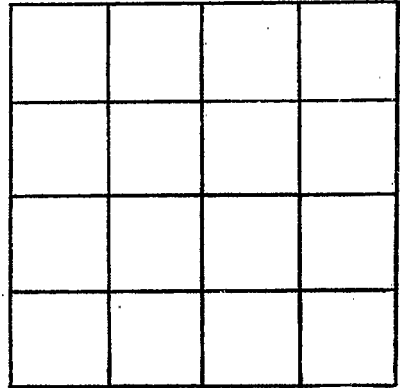

SECTION \_\_\_\_\_

Please indicate well location X.

ADDITIONAL INFORMATION

If more than one screen, show locations of each on sketch.