

Pearl River

X-65-148

4-6-75

MISSISSIPPI BOARD OF WATER COMMISSIONERS
W210 416 North State Street
Jackson, Mississippi 39201

CODED
CODED

WATER WELL DRILLERS LOG

4-6 1975 Earl Penton Pearl River
date well completed firm name county well located

LANDOWNER: Larry Huntington

Pearcyne, Miss

description of formations encountered	from	to
White shale	0	12
White sand	12	90
Blue shale	90	204
Blue sand	204	275
Blue shale	275	675
Blue sand	675	705
Blue shale	705	960
Blue sand	960	1080
Blue shale	1080	1125
Grey sand	1060	1123

(mailing address)

WELL LOCATION:

sec. 2 T 6 N 3 R 13 E 13 V
2.12 miles NE of Pearcyne
(distance) (direction) (nearest town)

WELL PURPOSE: Home
(home, irrigation, municipal, industrial)

WELL COMPLETION DATA:

- (1) diameter (inches) 2
- (2) total depth (feet) 1123
- (3) static water level (feet) below top of ground.
- (4) casing Galv. 1093
(material) (depth)

if telescope see back.
(size)

- (5) screen 2 x 30, 1093
(length) (depth to top)

12 Hammer Steel
(size) (material)

- (6) pump 1/2 15 1/2
(HP) (yield gpm)

(type power)


- (7) electric log (yes or no)

(organization running log)

- (8) how well bottom plugged Good Shale

DRILLERS REMARKS:


CODED

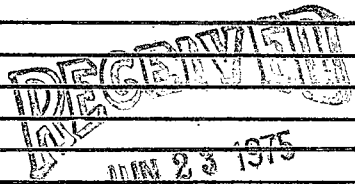

MISS. Bd. of Water Comm.

If well telescopes please sketch and show depths.

GROUND LEVEL

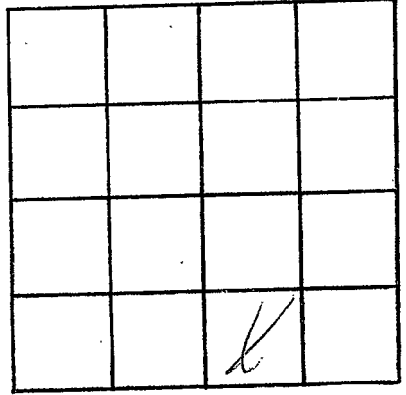

SECTION _____

Please indicate well location X.

ADDITIONAL INFORMATION

If more than one screen, show locations of each on sketch.