

Pearl River
 HATTU 212

MISSISSIPPI
 BOARD OF WATER COMMISSIONERS
 416 North State Street
 Jackson, Mississippi 39201

WATER WELL DRILLERS LOG

4/3/84 19 Stofford Wells Pearl River
 date well completed firm name county well located

LANDOWNER: C. N. Buntor

description of formations encountered	from	to
top soil	0	2

Picayune, Miss
 (mailing address)

sandy blue clay	2	30
-----------------	---	----

WELL LOCATION:
 sec. 2 T 5 N R 17 E
31 6 3 W 4 3
 (distance) miles (direction) of (nearest town)

sand	30	50
------	----	----

WELL PURPOSE: home
 (home, irrigation, municipal, industrial)

chalk	50	320
-------	----	-----

WELL COMPLETION DATA:

(1) diameter (inches) 2"
 (2) total depth (feet) 610
 (3) static water level (feet) flow below above top of ground.

sand	320	370
------	-----	-----

(4) casing plastic, 590
 (material) (depth)
2"
 (size) if telescope see back.

chalk	370	465
-------	-----	-----

(5) screen 20ft, 590
 (length) (depth to top)
2", plastic
 (size) (material)

fine sand	465	530
-----------	-----	-----


(6) pump _____ (HP) _____ (yield gpm)
 (type power)

chalk	530	570
-------	-----	-----

(7) electric log _____ (yes or no)
 (organization running log)

sand & gravel	570	610
---------------	-----	-----

(8) how well bottom plugged BWU

DRILLERS REMARKS:


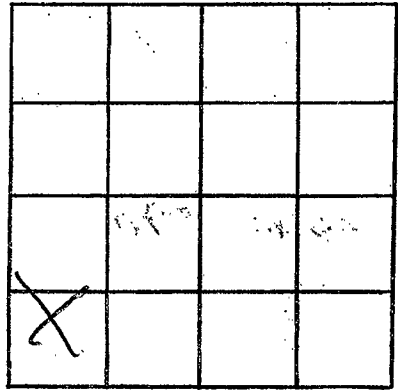
DEPT. OF NATURAL RESOURCES
 BUREAU OF LAND & WATER RESOURCES

MAY 23 1984

RECEIVED

If well telescopes please sketch and show depths.

GROUND LEVEL



SECTION _____

Please indicate well location X.

ADDITIONAL INFORMATION

If more than one screen,
show locations of each on sketch.