

MISSISSIPPI DEPARTMENT OF NATURAL RESOURCES

Bureau of Land and Water Resources

Southport Mall

P.O. Box 10631

Jackson, Mississippi 39209

WATER WELL DRILLERS LOG

CODED

PEARL RIVER  
W 213  
10-20-86

10-20 1986 PENTON WELL SERV. PEARL RIVER  
 date well completed firm name county well located

LANDOWNER: <u>LARRY ALDRITTON</u>	description of formations encountered	from	to
<u>1400 JACKSON LANDING Rd.</u> (mailing address)			
<b>WELL LOCATION:</b> sec. <u>1</u> T. <u>6</u> S. R. <u>18</u> E. <u>2</u> miles <u>WEST</u> of <u>PICAYUNE</u> (distance) (direction) (nearest town)	<u>CLAY</u>	<u>0</u>	<u>15</u>
<b>WELL PURPOSE:</b> <u>HOME</u> (home, irrigation, municipal, industrial)	<u>SAND &amp; GRAVEL</u>	<u>15</u>	<u>65</u>
<b>WELL COMPLETION DATA:</b>	<u>CLAY</u>	<u>65</u>	<u>280</u>
(1) diameter (inches) <u>2</u>	<u>SAND</u>	<u>280</u>	<u>450</u>
(2) total depth (feet) <u>1045</u>	<u>CLAY</u>	<u>450</u>	<u>800</u>
(3) static water level (feet) <u>Flow</u> below above top of ground.	<u>SAND</u>	<u>800</u>	<u>880</u>
(4) casing <u>PVC</u> , <u>1025</u> , (material) (depth)	<u>CLAY</u>	<u>880</u>	<u>975</u>
<u>2</u> if telescope see back. (size)	<u>SAND</u>	<u>975</u>	<u>1045</u>
(5) screen <u>20</u> , <u>1025</u> (length) (depth to top)			
<u>2</u> , <u>PVC</u> (size) (material)			
(6) pump _____ (HP) _____ (yield gpm)			
(type power)			
(7) electric log <u>NO</u> (yes or no)			
(organization running log)			
(8) how well bottom plugged <u>BW</u>			

CODED

RECEIVED


NOV 12 1986

Department of Natural Resources  
 Bureau of Land & Water Resources

DRILLERS REMARKS:

If well telescopes please sketch and show depths.

GROUND LEVEL

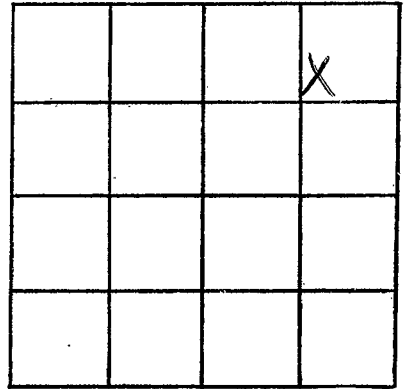

SECTION \_\_\_\_\_

Please indicate well location X.

ADDITIONAL INFORMATION

If more than one screen,  
show locations of each on sketch.