

MISSISSIPPI DEPARTMENT OF NATURAL RESOURCES

Bureau of Land and Water Resources

Southport Mall

P.O. Box 10631

Jackson, Mississippi 39209

WATER WELL DRILLERS LOG

P. RIVER
W 220

CODED

8-25 1982
date well completed

Bud Penton Water Well
firm name

Pearl River
county well located

LANDOWNER: Alan Stockstill
Rt 5 Box 578 Picayune
Ms. 39466
(mailing address)


WELL LOCATION:
sec. 2 T. 7 N. R. 17 E
S W
2 miles EAST of Nicholson
(distance) (direction) (nearest town)

WELL PURPOSE: irrigation
(home, irrigation, municipal, industrial)

WELL COMPLETION DATA:

- (1) diameter (inches) 5
- (2) total depth (feet) 997
- (3) static water level (feet) flow below above
top of ground.
- (4) casing PVC 987'
(material) (depth)
2" if telescope see back.
(size)
- (5) screen 10 987'
(length) (depth to top)
2" PVC
(size) (material)
- (6) pump _____
(HP) (yield gpm)
(type power)
- (7) electric log no
(yes or no)
(organization running log)
- (8) how well bottom plugged sandshark

description of formations encountered	from	to
Gray shale	0	41
White sand	41	80
Blue shale	80	212
Gray sand	212	232
Blue shale	232	410
Gray sand	410	546
Blue shale	546	610
Blue sand	610	645
Blue shale	645	652
Blue sand	652	737
Blue shale	737	800
Blue sand	800	997

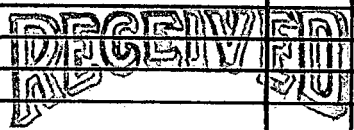


SEPT 8 1992

Dept. of Environmental Quality
Bureau of Land & Water Resources

DRILLERS REMARKS:

If well telescopes please sketch and show depths.

GROUND LEVEL

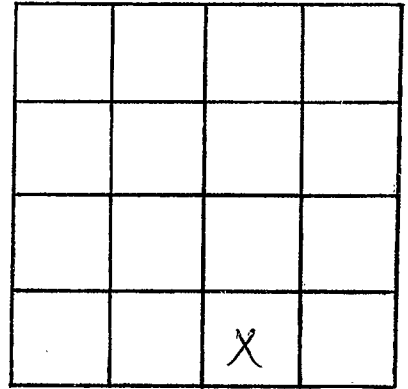

SECTION 2

Please indicate well location X.

ADDITIONAL INFORMATION

If more than one screen,
show locations of each on sketch.