


If well telescopes please sketch and show depths.

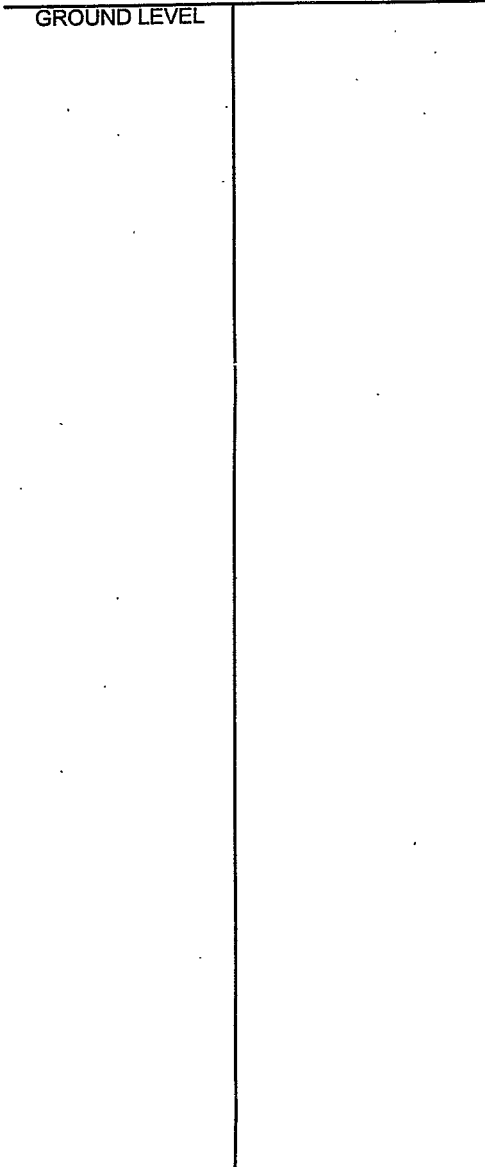

If more than one screen, show location of each on sketch.

SECTION 9

Please indicate well location X.

Pump Capacity (GPM) 1000 695	No. of Stages 5	Setting Depth 156 FT.
PUMP TEST		
Well yielded <u>697</u> GPM with		
a drawdown of <u>36.67</u> ft.		
after <u>2</u> hours of pumping.		

LOG DATA

TYPE OF LOG RUN (Circle One): No Log Run, (Electric,) (Gamma Ray,) Density, Sonic, Neutron, Other (Describe) _____

Name of Organization Running Log

Griner Drilling Service

GEOLOGIC DATA (Office Use Only)

Surface Elev.	Geologic Unit	Unit Thickness	Depth to Top
Subs. SWL	Date	Analysis	Aquifer Test

Driller's Remarks
