

County: PEARL-RIVER
 Permit #: 059
 Driller: JOCK R. B...
 Date drilling completed: 9/15/06

State Well Report
Part 1 - Driller's Log

Mississippi Department of Environmental Quality
 Office of Land and Water Resources
 P.O. Box 10631
 Jackson, MS 39289-0631
 (601)961-5210
 (601)354-6938 (fax)

For Office Use Only:
 Aquifer: _____
 Well #: W-243
 L. S. Elevation: _____
 E-log #: _____

State Law requires that this report be prepared by the license holder responsible for the work and filed with the Department at the above address within 30 days of completion of drilling of the well or borehole.

Information on Well Owner <small>(Landowner if borehole is not for a water well)</small>	Well or Borehole Location
Owner Name: <u>FRANCKI MOODY</u>	Latitude: _____ Longitude: _____
Mailing Address: <u>TEASX FLAT RD</u> <u>PICAYUNE MS.</u>	Method of Lat/Long (circle one): Conventional Survey, USGS quad, Hand-held GPS, Survey-grade GPS
City State Zip Code <u>39464</u>	<u>30</u> 1/4 <u>30</u> 1/4 Sec <u>24</u> Twn <u>6-S</u> Rng <u>17 W</u>
Telephone No. <u>601-273-6707</u>	Distance Direction Nearest Town <u>4</u> Miles <u>SOUTH</u> of <u>PICAYUNE MS</u>
Well / Borehole Data	
Date drilling started: <u>9/15/06</u> Date drilling completed: <u>9/15/06</u> Hole depth: <u>53'</u> Hole diameter: <u>5 1/2"</u>	
Location of the source of any surface water used for drilling: _____ Method of dosing and volume of Chlorine used in drilling and development: <u>BLEACH</u>	
Logs run (circle all applicable): No log run Electric Gamma Ray Density Sonic Neutron Other: _____ Name of organization running log(s): _____	
Purpose of borehole (check one): Water Well <input checked="" type="checkbox"/> Geotechnical/Geological Investigation _____ Ground Source Heat Pump _____ Seismic Survey _____ Other (describe) _____	
<i>If drilling is not related to water well construction, skip the remainder of this block</i>	
Purpose of Well (check one): Home _____ Industrial _____ Public Supply _____ Irrigation _____ Fish Culture _____ Other: <u>MVA BORG</u>	
If a flowing well, method of flow regulation: Valve _____ Other (describe) _____	
Static Water Level: <u>15</u> feet above or below (circle one) land surface Date measured: <u>9/15/06</u>	
Method of Measurement (circle one) steel tape electric tape air line other: <u>STRING</u>	
Well depth: <u>53'</u> Well grouted to a depth of <u>10</u> feet Type of grout (circle one): Neat Cement Bentonite <u>Mix</u>	
Casing length: <u>43</u> feet Casing diameter: <u>4</u> inches Type of casing: <u>PVC</u>	
Screen length: <u>10</u> feet Screen diameter: <u>4</u> inches Type of screen: <u>SLOT</u>	
Screen slot size: <u>10</u> inches Setting depth: From <u>43'</u> feet to <u>53'</u> feet	
Type of completion (circle all applicable): Gravel packed Underreamed Telescoped Open hole <u>Natural Development</u> Other (describe): <u>AIR HOSE</u>	
Top of lap pipe or reduction in casing: _____ feet. <i>If telescoped or more than one screen, describe on next page</i>	

Form: OLWR-SWR-1A


RECEIVED
 NOV 22 2006
 BY: OLWR

FRANK MOODY

W-243

The sketch below only required for water wells

If well telescopes, show depths on sketch.

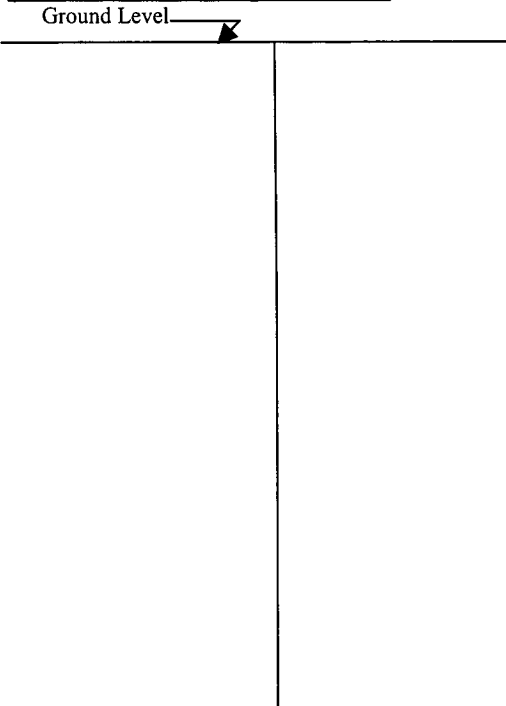


Description of formations encountered must be provided for all wells and boreholes, unless specifically exempted by regulations

Description of Formations Encountered	From (depth)	To (depth)
	Ground Level	
DIACONITE	0	10
WHITE CLAY	10	15
SAND	15	20
Rock SAND	20	40
ROCK	40	53

If more than one screen, show location of each on sketch

Sketch the property layout and include the following: 1) the well location; 2) any permanent structures on the property that may aid in locating the well; 3) any roads, power lines, or other items that may aid in locating the property and the well; 4) a north arrow.

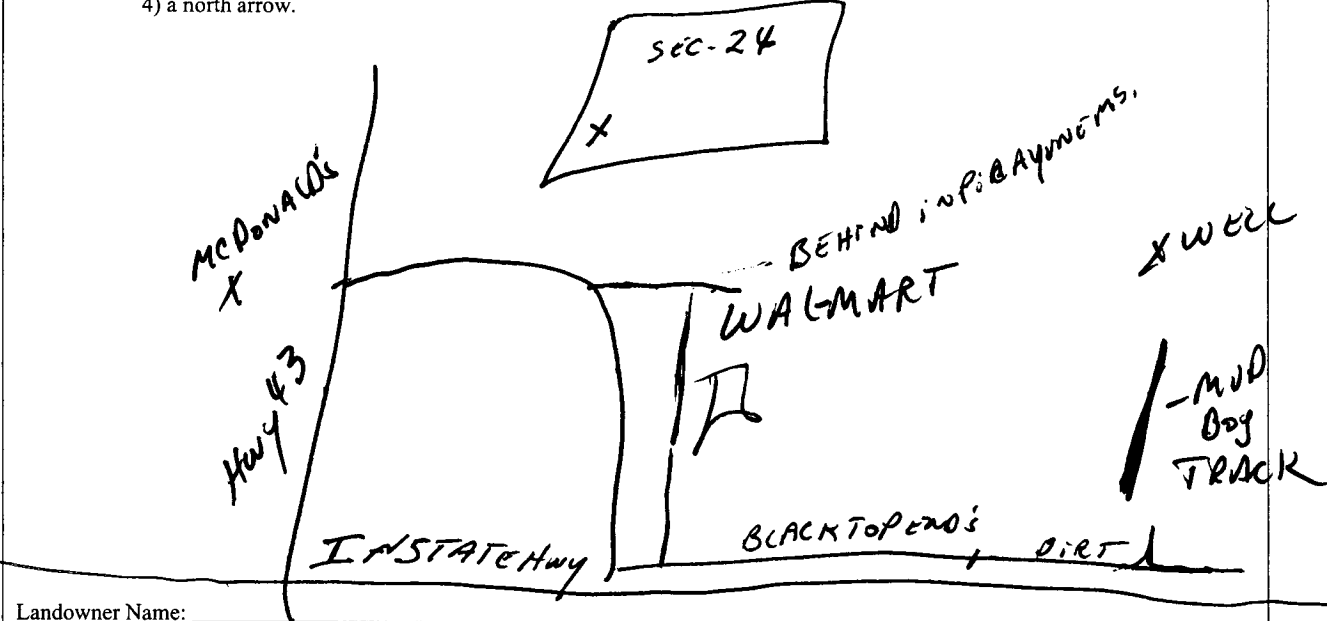

Landowner Name: _____

Form: OLWR-SWR-1A

I certify that the well/borehole was drilled, constructed, and completed in accordance with all applicable requirements of the Mississippi Department of Environmental Quality and the Mississippi Department of Health regulations, if applicable, and state laws.

Jock R. Ben

10/15/06

Jock R. Ben

Print Name of Responsible Licensee and License No.

Date

Signature of Licensee

RECEIVED
NOV 22 2006
BY: OLWR

STATE WELL REPORT

Part 2

Pump Installer's Completion Report
 Mississippi Department of Environmental Quality
 Office of Land and Water Resources
 P.O. Box 10631
 Jackson, MS 39289-0631
 (601)961-5210
 (601)354-6938 (fax)

County: PEARL RIVER
 Permit #: 0519
 Driller: JOCK BURR
 Date completed: 10/16/04
Copy information from block on Part 1

For Office Use Only:

Aquifer: _____
 Well #: W-243
 Elevation: _____

This part of the report must be completed by a licensed water well contractor or a licensed pump installer. A copy of Part 1 of the report must be attached and both parts filed with the Department at the above address within 30 days of well completion.

Well Owner Information	Well Location
Owner Name: <u>FRANKIE MOODY</u>	Latitude: _____ Longitude: _____
Mailing Address: <u>TRAVIS FEATRD</u> <u>PRAYNE MS</u>	Method of Lat/Long (check one): Conventional Survey _____ USGS quad <input checked="" type="checkbox"/> Hand-held GPS _____ Survey-grade GPS _____
City: _____ State: _____ Zip Code: <u>39416</u>	<u>30</u> ¹ / ₄ <u>30</u> ¹ / ₄ Sec <u>29</u> T <u>6-S</u> R <u>17W</u>
Telephone No. <u>601-273-6707</u>	Distance _____ Direction _____ Nearest Town _____ <u>1/4</u> Miles NORTH ^{SOUTH} of <u>PICAYNEE</u>

Pump Type Circle one	Power Type Circle one
Air Lift Jet <u>Submersible</u>	Diesel Engine Gasoline Engine Natural Gas
Bucket Piston Turbine	<u>Electric Motor</u> Hand Tractor PTO
Centrifugal Rotary Flowing Well	Windmill Other (specify): _____
Other (specify): <u>STARITE</u>	Horse Power Rating of Motor: <u>1</u>
Date Pump Installed: <u>10/16/04</u>	Setting Depth: <u>90</u> feet
Rated Pump Capacity: <u>20</u> Gallons Per Minute	Number of Stages: <u>2</u>

Pump Test Data	Method of Measuring Water Level Circle one
Date Well Tested: <u>10/16/04</u>	Air Line Electric Measuring Line Steel Tape
Static Water Level (A): <u>10</u> Feet Below Land Surface	Other (specify): <u>STRONG</u>
Pumping Water Level (B): _____ Feet Below Land Surface	For flowing well, measured shut in head: _____ feet
Drawdown [(B) - (A)]: _____ Feet Below Land Surface	Well yielded _____ GPM with a drawdown of _____ feet after _____ hours of pumping
Test Pumping Rate: <u>30</u> Gallons Per Minute	
Duration of Pump Test (minimum 4 hours): <u>4</u> hours	

I HEREBY CERTIFY that the above statements are true to the best of my knowledge.

JOCK R. BURR JOCK BURR
 Print Name of Pump Installer and License No. (if applicable) Signature of Pump Installer

Form: OLWR-SWR-11
RECEIVED
 NOV 22 2006
 BY: OLWR