

Pearl R.

MISSISSIPPI BOARD OF WATER COMMISSIONERS

W 2000

7-31-62

WATER WELL DRILLERS LOG

Date: 7-31, 1962, Driller: Sutter Well Works County Pearl River
(Name)


	Description & Color of Materials Sand, Clay, Red Clay, Shell, etc.	Thick- ness Feet	Depth Feet
(1) Owner of Land: <u>2. J. Higgins</u> (Name)	Surface sand	45	45
<u>Rt 1 Box 342 - Picayune</u> (Address)	Clay	85	130
(2) Location: <u>1/4</u> , <u>Between</u> <u>1/4</u> , Sec. <u>2-3 T&SR 17W</u>	sand	25	155
<u>2</u> miles <u>SW</u> of <u>Richardson</u> (distance) (direction) (Nearest Town)	Clay	105	260
(3) Topography: <u>hilly</u> (Hilly) (Flat) (Level)	Sand	20	280
(4) Purpose of Well: <u>domestic</u> (Domestic Irrigation Municipal, Industrial, Other)			

Information upon completion of well:

- (1) Diameter 2 inches.
- (2) Total Depth 280 feet.
- (3) Water Level 49 feet below top of ground.
- (4) Cased to all, Size 2"
- (5) Screen: Size 2", Length 5'
- (6) Were any formations sealed against pollution?
no

If YES depth of formation _____
Why _____

Drillers Remarks: _____

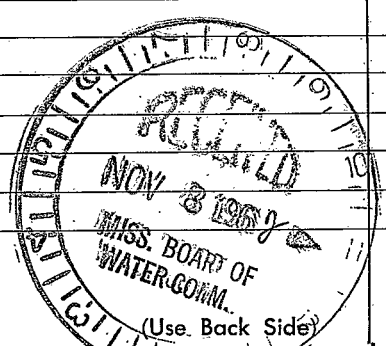

Well No. _____

