

Pearl R.

MISSISSIPPI BOARD OF WATER COMMISSIONERS

W 2003

3-11-66

WATER WELL DRILLERS LOG

Pearl River

Date: 3-11, 1966, Driller: Sutter Well Works County Hancock

(Name)

(1) Owner of Land: Gulf Oil Co. through W. M. CRAIG (Name)

Gulfport Miss. (Address)

(2) Location: SE 1/4, NW 1/4, Sec. 3 T15R17W

1 miles S of Nicholson (distance) (direction) (Nearest Town)

(3) Topography: hilly (Hilly) (Flat) (Level)

(4) Purpose of Well: Service station (Domestic Irrigation Municipal, Industrial, Other)

Description & Color of Materials Sand, Clay, Red Clay, Shell, etc.	Thick- ness Feet	Depth Feet
Clay	35	35
sand	52	87
Clay - sand streaks	106	193
sand	102	295
Clay	81	376
sand	8	384
Clay	16	400
sand	53	453

Information upon completion of well:

(1) Diameter 2 inches.

(2) Total Depth 453 feet.

(3) Water Level 16 feet below top of ground.

(4) Cased to all, Size 2"

(5) Screen: Size 2", Length 10'


(6) Were any formations sealed against pollution?

yes, no.

If YES depth of formation surface

Why

Drillers Remarks:

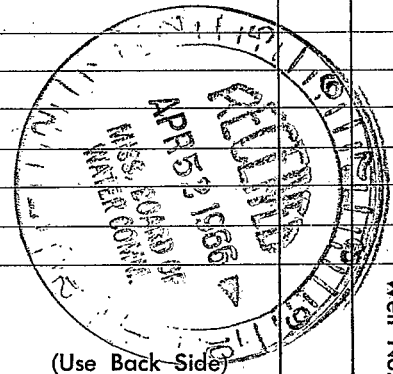

(Use Back Side)

Well No.

1870

1871

1872

1900