

Pearl River  
Wash  
7-67

MISSISSIPPI  
 BOARD OF WATER COMMISSIONERS  
 416 North State Street  
 Jackson, Mississippi 39201

WATER WELL DRILLERS LOG

7-21-67 19 Neil Lumpkin Well Pearl River  
 date well completed firm name county well located  
Aug. Service

LANDOWNER Lutheran Church

description of formations encountered	from	to
<u>white clay</u>	<u>0</u>	<u>20</u>
<u>sand &amp; gravel</u>	<u>20</u>	<u>110</u>
<u>Blue clay</u>	<u>110</u>	<u>390</u>
<u>good sand</u>	<u>390</u>	<u>442</u>

Picayune, Miss.  
 (mailing address)

WELL LOCATION:  
 sec 29 T 6 S R 14 W  
1/2 miles SOUTH of PICAYUNE  
 (distance) (direction) (nearest town)

WELL PURPOSE: Church  
 (home, irrigation, municipal, industrial)

WELL COMPLETION DATA:

- (1) diameter (inches) 2"
- (2) total depth (feet) 442'
- (3) static water level (feet) 27' below top of ground.
- (4) casing galv. 437'  
 (material) (depth)  
2" If telescope see back.  
 (size)
- (5) screen 5' 437'  
 (length) (depth to top)  
2" Stainless Steel  
 (size) (material)
- (6) pump 1 800 per hr.  
 (HP) (yield gpm)  
Electric  
 (type power)
- (7) electric log No  
 (yes or no)  
 (organization running log)

(8) how well bottom plugged Johnson  
B Valve


DRILLERS REMARKS: a very good pump well.



If well telescopes please sketch and show depths.

GROUND LEVEL

Hiway 11

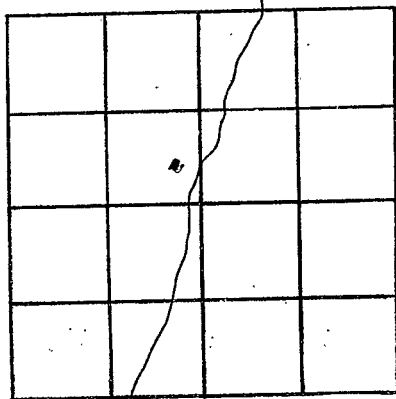

SECTION 27

Please indicate well location X.

ADDITIONAL INFORMATION

If more than one screen, show locations of each on sketch.