

Pearl River
W 2000
2/68

MISSISSIPPI
 BOARD OF WATER COMMISSIONERS
 416 North State Street
 Jackson, Mississippi 39201

WATER WELL DRILLERS LOG

Feb. 1, 1968 NEIL LUMPKIN WELL Pearl River
 date well completed firm name SERVICE county well located

LANDOWNER: Samuel Hearcy
3317 Jackson Blvd.
Chalmette, La. 70043
 (mailing address)

description of fomations encountered	from	to
<u>Surface Clay</u>	<u>0</u>	<u>10</u>
<u>Surface Sand & Gravel</u>	<u>10</u>	<u>50</u>
<u>Hard blue clay</u>	<u>50</u>	<u>280</u>
<u>Good Sand</u> (Fines to better)	<u>280</u>	<u>346</u>

WELL LOCATION:
 sec. 17 T 10 S R 18 E
6 miles West of Perryman
 (distance) (direction) (nearest town)

WELL PURPOSE: home
 (home, irrigation, municipal, industrial)

WELL COMPLETION DATA:

(1) diameter (inches) 2"

(2) total depth (feet) 341'

(3) static water level (feet) 10' below above top of ground.


(4) casing galv. 336'
 (material) (depth)
2" if telescope see back.
 (size)

(5) screen 5'
 (length) (depth to top)
2" plastic
 (size) (material)

(6) pump 1/2 Cooper
 (HP) (yield gpm)
electric
 (type power)

(7) electric log No.
 (yes or no)
 (organization running log)


(8) how well bottom pluggad Johnson
BP Valve

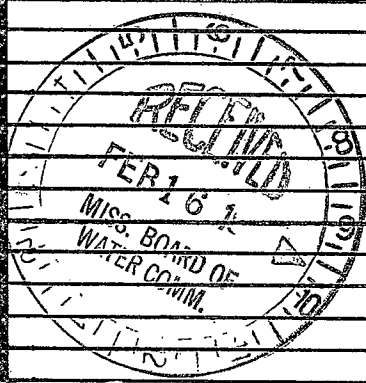

DRILLERS REMARKS: very good well.

If well telescopes please sketch and show depths.

GROUND LEVEL

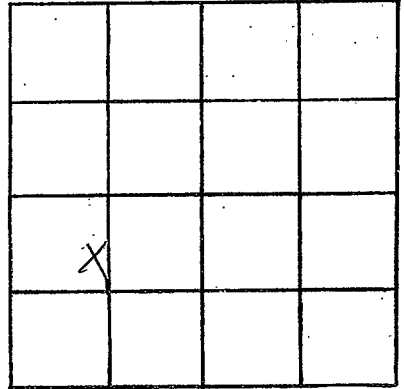

SECTION 7

Please indicate well location X.

ADDITIONAL INFORMATION

If more than one screen, show locations of each on sketch.