

need date

Pearl River  
W 2008  
/76

MISSISSIPPI  
BOARD OF WATER COMMISSIONERS  
416 North State Street  
Jackson, Mississippi 39201

WATER WELL DRILLERS LOG

1976 Periton well Serv Pearl River

date well completed

firm name

county well located

LANDOWNER: Live Oak Plantation

13V

Description of formations encountered

from

to

Surface clay

0

20

Sand

20

100

Blue clay

100

380

Sand

380

409

Picayune MS

(mailing address)

WELL LOCATION:

sec 25 T 6 N R 12 E  
S W

1/2 miles South of Picayune  
(distance) (direction) (nearest town)

WELL PURPOSE: Farm  
(home, irrigation, municipal, industrial)

WELL COMPLETION DATA:

- (1) diameter (inches) 2
- (2) total depth (feet) 409
- (3) static water level (feet) 17 below top of ground.
- (4) casing Galv. 399 (material) (depth)  
2 (size) If telescope see back.
- (5) screen 10 399 (length) (depth to top)  
2 S. steel (size) (material)
- (6) pump 1 12 (HP) (yield gpm)  
Elec (type power)
- (7) electric log NO (yes or no)

(organization running log)

(8) how well bottom plugged: BW Valve


DRILLERS REMARKS:

RECEIVED  
JAN - 8 1976

MISS. BD. OF WATER COMMISSIONERS

If well telescopes please  
sketch and show depths.

GROUND LEVEL

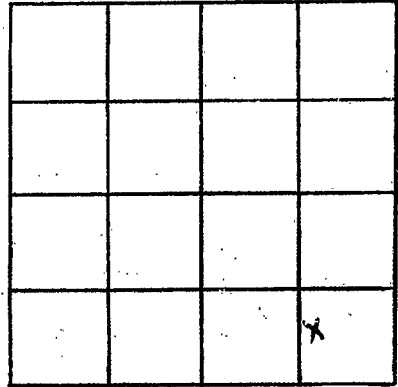

SECTION 25

Please indicate well location X.

ADDITIONAL INFORMATION

If more than one screen,  
show locations of each on sketch.