

Pearl River
W 200
8-9-76

MISSISSIPPI
 BOARD OF WATER COMMISSIONERS
 416 North State Street
 13V Jackson, Mississippi 39201

WATER WELL DRILLERS LOG

Aug 9 1976 Lumpkin Well Co. P. R.
 date well completed firm name county well located

LANDOWNER: Mr. Merga Raper
Picayune, Miss.
 (mailing address)

description of formations encountered

from	to
<u>0</u>	<u>15</u>
<u>15</u>	<u>71</u>

Clay
sand

WELL LOCATION:
1/2 sec 17 W
1 T 6 N
 miles of 17 miles
 (distance) (direction) (nearest town)

WELL PURPOSE:
 (home, irrigation, municipal, industrial)

- WELL COMPLETION DATA:
- (1) diameter (inches) 4"
 - (2) total depth (feet) 71'
 - (3) static water level (feet) 40' below above top of ground.
 - (4) casing P.V.C. 60'
 (material) (depth)
4" If telescope see back.
 (size)
 - (5) screen 4" 60'
 (length) (depth to top)
4" P.V.C.
 (size) (material)
 - (6) pump 1/2 166 P.M
 (HP) (yield gpm)
Elec.
 (type power)
 - (7) electric log No.
 (yes or no)
No
 (organization running log)
 - (8) how well bottom plugged See sketch


RECEIVED
 OCT 26 1976

MISS. BD. OF WATER COMMISSIONERS

DRILLERS REMARKS:

If well telescopes please
sketch and show depths.

GROUND LEVEL

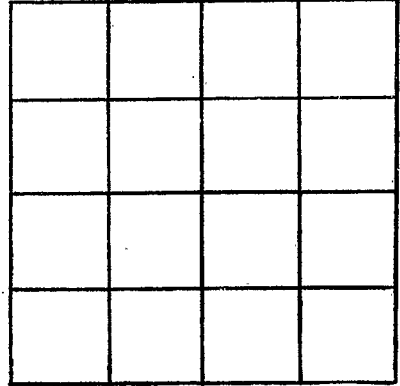

SECTION _____

Please indicate well location X.

ADDITIONAL INFORMATION

If more than one screen,
show locations of each on sketch.