

Pearl River
 W 200
 3-11-77

~~(Pearl River)~~
~~(W 200)~~
~~(3-11-77)~~

MISSISSIPPI
 BOARD OF WATER COMMISSIONERS
 416 North State Street
 Jackson, Mississippi 39201

WATER WELL DRILLERS LOG

2-11 1977 Bouncewater well Pearl River
 date well completed firm name county well located

LANDOWNER: Roy Bunkle
Rt. 1 Canyon MS
Kenefield 39466
 (mailing address)

description of formations encountered	from	to
	Clay	0
sd clay mix	20	36
sd s	36	67

WELL LOCATION:
 sec. 4 T. 1 S. R. 17 E. W.
1.1 miles W of Pearl River
 (distance) (direction) (nearest town)

WELL PURPOSE: Home
 (home, irrigation, municipal, industrial)

- WELL COMPLETION DATA:
- (1) diameter (inches) 4
 - (2) total depth (feet) 67
 - (3) static water level (feet) 33 below top of ground
 - (4) casing 57 PVC
 (material) (depth)
4 if telescope see back.
 (size)
 - (5) screen 10 57
 (length) (depth to top)
4 PVC
 (size) (material)
 - (6) pump 1 6
 (HP) (yield gpm)
110 AC
 (type power)
 - (7) electric log _____
 (yes or no)

 (organization running log)
 - (8) how well bottom plugged Sealed


DRILLERS REMARKS: Shallow surface well

RECEIVED
 AUG 26 1977

MISS. BLDG. WATER COMMISSION

If well telescopes please sketch and show depths.

GROUND LEVEL

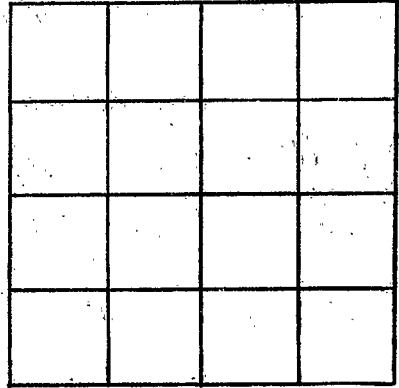

SECTION _____

Please indicate well location X.

ADDITIONAL INFORMATION

If more than one screen, show locations of each on sketch.