

Pearl River  
W 2011  
9-20-77

MISSISSIPPI  
 BOARD OF WATER COMMISSIONERS  
 416 North State Street  
 Jackson, Mississippi 39201

WATER WELL DRILLERS LOG

9-20 1977 STOCKSTILL BROS., INC. Pearl River  
 date well completed name county well located

LANDOWNER: Mrs. John Sellers  
Rt. Peayune, Miss  
 (mailing address)

description of formations encountered	from	to
Clay	0	15
Sand	15	105
Clay	105	270
Sand	270	305

WELL LOCATION:  
 sec. 2 T 7 N R 18 E  
4 miles S.W. of Peayune  
 (distance) (direction) (nearest town)

WELL PURPOSE: Home  
 (home, irrigation, municipal, industrial)


- WELL COMPLETION DATA:
- (1) diameter (inches) 2"
  - (2) total depth (feet) 305
  - (3) static water level (feet) 40' below top of ground.
  - (4) casing P.V.C., 300,  
 (material) (depth)  
2" if telescope see back.  
 (size)
  - (5) screen 5, 300'  
 (length) (depth to top)  
2", P.V.C.  
 (size) (material)
  - (6) pump 1/2, 15  
 (HP) (yield gpm)  
Elec.  
 (type power)
  - (7) electric log No  
 (yes or no)  
No  
 (organization running log)
  - (8) how well bottom plugged Sand Shale

SEP 22 1977  
 MISS. BD. OF WATER COMMISSIONERS

DRILLERS REMARKS:

If well telescopes please  
sketch and show depths.

GROUND LEVEL

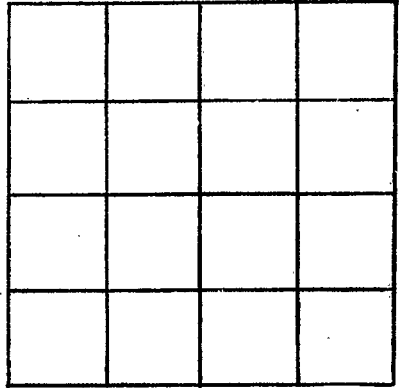

SECTION \_\_\_\_\_

Please indicate well location X.

ADDITIONAL INFORMATION

If more than one screen,  
show locations of each on sketch.