

Pearl R.
 W2013
 12/1/77

MISSISSIPPI
 BOARD OF WATER COMMISSIONERS
 416 North State Street
 Jackson, Mississippi 39201

WATER WELL DRILLERS LOG

12-1-77 date well completed
 Bud Center firm name
 Pearl River county well located

LANDOWNER:
 R E Ulagich
 Ocean Springs, Ms
 (mailing address)

description of formations encountered	from	to
White Shale	0	10
White Sand	10	28
Blue Shale	28	100
Grey Sand	100	190

WELL LOCATION:
 sec. 10 T. 6 N. R. 18 E.
 6 S. Ocean Springs
 (distance) miles (direction) (nearest town)

WELL PURPOSE: Home
 (home, irrigation, municipal, industrial)

WELL COMPLETION DATA:

(1) diameter (inches) 4 in

(2) total depth (feet) 190

(3) static water level (feet) 12 below top of ground

(4) casing PVC 180 (material) (depth)

(size) if telescope see back:

(5) screen 4x10 180 (length) (depth to top)
 12 PVC (size) (material)

(6) pump 1/2 750 130 gpm (HP) (yield gpm)
 Electric (type power)

(7) electric log NO (yes or no)

(organization running log)

(8) how well bottom plugged Sand Shand


DRILLERS REMARKS:

RECEIVED
 DEC 30 1977

MISS. BD. OF WATER COMMISSIONERS

If well telescopes please sketch and show depths.

GROUND LEVEL

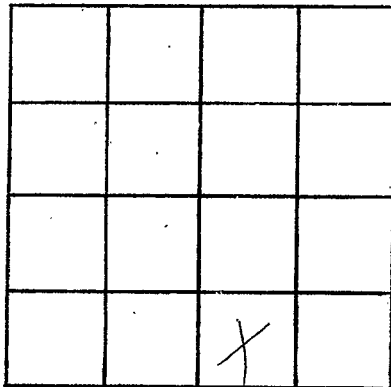

SECTION _____

Please indicate well location X.

ADDITIONAL INFORMATION

Lined area for additional information.

If more than one screen, show locations of each on sketch.