

PEARL RIVER
 W 2006
 3/21/78

MISSISSIPPI
 BOARD OF WATER COMMISSIONERS
 416 North State Street
 Jackson, Mississippi 39201

WATER WELL DRILLERS LOG

3/21 1978 Red River Drilling Pearl River
 date well completed firm name county well located

LANDOWNER: James J. Wicks
Pearl River Miss.
 (mailing address)

description of formations encountered	from	to
Red shale	0	38
50' blue sand	38	66
Blue sand	66	230
Blue sand	230	255

WELL LOCATION:
 sec. 8 T. 7 N. R. 18 E
1 miles East of Pearl River
 (distance) (direction) (nearest town)

WELL PURPOSE: Home
 (home, irrigation, municipal, industrial)

- WELL COMPLETION DATA:
- (1) diameter (inches) 2
 - (2) total depth (feet) 255
 - (3) static water level (feet) 30 below/above top of ground.
 - (4) casing PVC (material), 245' (depth)
20 (size) if telescope see back.
 - (5) screen 2x10 (length), 245' (depth to top)
12 (size), PVC (material)
 - (6) pump 1/2 (HP), 400 (yield gpm)
Elect (type power)
 - (7) electric log NO (yes or no)

(organization running log)
 (8) how well bottom plugged Shank

DRILLERS REMARKS:


RECEIVED

JUL 14 1978

MISS. BD. OF WATER COMM

If well telescopes please sketch and show depths.

GROUND LEVEL

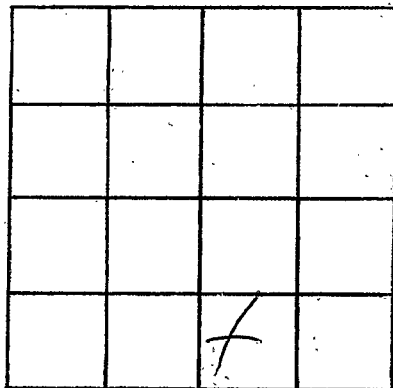

SECTION _____

Please indicate well location X.

ADDITIONAL INFORMATION

If more than one screen,
show locations of each on sketch.