

PEARL RIVER

W

2017

MISSISSIPPI BOARD OF WATER COMMISSIONERS 416 North State Street Jackson, Mississippi 39201

WATER WELL DRILLERS LOG

6-19 date well completed

1978 Bud Pentonson firm name

Paul River county well located

LANDOWNER: James Strickland Piquette, Mo. (mailing address)

Table with 4 columns: description of formations encountered, from, to. Rows include White Shale, White Sand, Blue Shale, Grey Sand with corresponding depth values.


WELL LOCATION: sec 4 T 6 N R 17 E S W 1/2 miles E of Piquette (distance) (direction) (nearest town)

WELL PURPOSE: Home (home, irrigation, municipal, industrial)

- WELL COMPLETION DATA: (1) diameter (inches) 2 in (2) total depth (feet) 235 (3) static water level (feet) 23 below top of ground. (4) casing PVC, 235 (material) (depth) (5) screen 2x10, 225 (length) (depth to top) 12, PVC (size) (material) (6) pump 1/2, 350 (HP) (yield gpm) electric (type power) (7) electric log No (yes or no)

(organization running log) (8) how well bottom plugged Sand Shark


DRILLERS REMARKS:

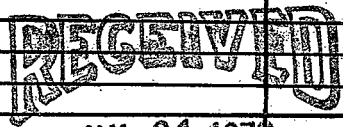

JUL 31 1978

If well telescopes please sketch and show depths.

GROUND LEVEL

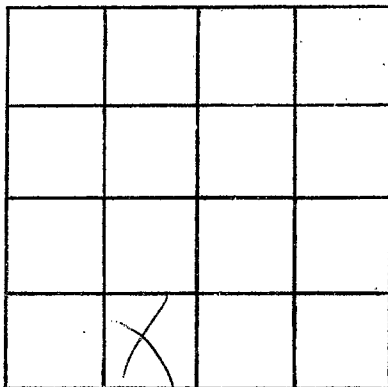

SECTION _____

Please indicate well location X.

ADDITIONAL INFORMATION

If more than one screen,
show locations of each on sketch.