

PEARL RIVER  
 W 2018  
 7-28-78

MISSISSIPPI  
 BOARD OF WATER COMMISSIONERS  
 416 North State Street  
 Jackson, Mississippi 39201

WATER WELL DRILLERS LOG

7/28 1978 Bud Panton Pearl River  
 date well completed firm name county well located

LANDOWNER: D. B. Panton	description of formations encountered	from	to
(mailing address)			
Box 1 Pagan	Red shale	0	29
Miss -	White to gray	29	75
	blue shale	75	260
	Gray sand	260	300

WELL LOCATION:  
 sec. 4 T. 6 N R. 17 E  
 S W  
 2 miles N of Pagan  
 (distance) (direction) (nearest town)

WELL PURPOSE: home  
 (home, irrigation, municipal, industrial)

WELL COMPLETION DATA:

(1) diameter (inches) 2"

(2) total depth (feet) 300

(3) static water level (feet) 30' below top of ground

(4) casing galv. 290  
 (material) (depth)  
 no if telescope see back.  
 (size)

(5) screen 2x10 290  
 (length) (depth to top)  
 12 galv.  
 (size) (material)


(6) pump 1 650  
 (HP) (yield gpm)  
 elect.  
 (type power)

(7) electric log no  
 (yes or no)

(organization running log)

(8) how well bottom plugged  
 Sand  
 Sharp.


DRILLERS REMARKS:

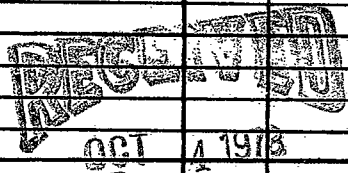

MISS. BD. OF WATER COMM.

If well telescopes please sketch and show depths.

GROUND LEVEL

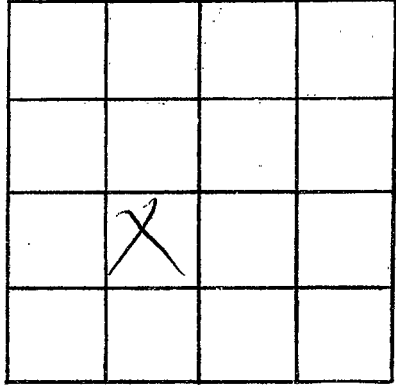

SECTION \_\_\_\_\_

Please indicate well location X.

ADDITIONAL INFORMATION

If more than one screen,  
show locations of each on sketch.