


PEARL RIVER  
 W 209  
 8-4-78

MISSISSIPPI  
 BOARD OF WATER COMMISSIONERS  
 416 North State Street  
 Jackson, Mississippi 39201

WATER WELL DRILLERS LOG

8-4-78 19 Pentoni Well Serv Pearl River  
 date well completed firm name county well located


LANDOWNER: <u>T.C. Martin</u>	description of formations encountered	from	to
<u>Picayune, ms.</u> (mailing address)			
WELL LOCATION: sec. <u>2</u> T. <u>6</u> N R. <u>17</u> E S W	<u>Sand</u>	<u>20</u>	<u>30</u>
<u>1</u> miles <u>North</u> of <u>Picayune</u> (distance) (direction) (nearest town)	<u>Blue Clay</u>	<u>30</u>	<u>175</u>
WELL PURPOSE: <u>home</u> (home, irrigation, municipal, industrial)	<u>Sand</u>	<u>175</u>	<u>190</u>
WELL COMPLETION DATA: (1) diameter (inches) <u>2"</u>	<u>Blue Clay</u>	<u>190</u>	<u>300</u>
(2) total depth (feet) <u>346'</u>	<u>Sand</u>	<u>300</u>	<u>346</u>
(3) static water level (feet) <u>25'</u> <u>below</u> <u>above</u> top of ground.			
(4) casing <u>Galv.</u> <u>336'</u> (material) (depth)			
<u>2"</u> (size) if telescope see back.			
(5) screen <u>10'</u> <u>336'</u> (length) (depth to top)			
<u>2"</u> <u>S. Steel</u> (size) (material)			
(6) pump <u>1/2</u> <u>8</u> (HP) (yield gpm)			
<u>Elec</u> (type power)			
(7) electric log <u>No</u> (yes or no)			
(organization running log)			
(8) how well bottom plugged <u>B.W. Oaloe</u>			
DRILLERS REMARKS:			

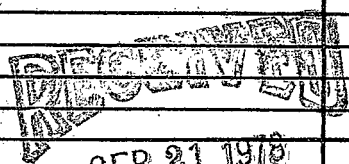

MISS. BD. OF WATER COMM.

If well telescopes please sketch and show depths.

GROUND LEVEL

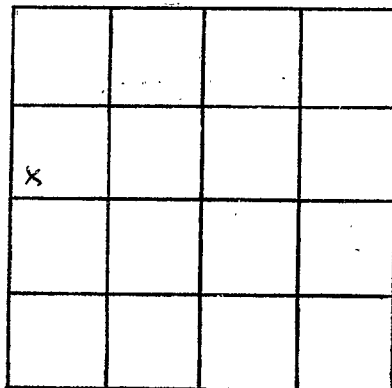

SECTION 2

Please indicate well location X.

ADDITIONAL INFORMATION

Lined area for additional information.

If more than one screen, show locations of each on sketch.