

PEARL RIVER

W 2021

04-10-79

MISSISSIPPI
BOARD OF WATER COMMISSIONERS
416 North State Street
Jackson, Mississippi 39201

WATER WELL DRILLERS LOG

4-10-1979 Penitons Well Serv Pearl River
date well completed firm name county well located

LANDOWNER: T. C. Martin

Carriere, MS.

(mailing address)

description of formations encountered

from

to

Surface Clay

0 50

Sand

50 85

Blue Clay

85 280

Sand

280 340

WELL LOCATION:

sec. 2 T. 6 R. 17
S W
1/2 miles north of Poyzane
(distance) (direction) (nearest town)

WELL PURPOSE: Home
(home, irrigation, municipal, industrial)

WELL COMPLETION DATA:

- (1) diameter (inches) 2
- (2) total depth (feet) 340
- (3) static water level (feet) 23' below top of ground. above
- (4) casing Galv 320
(material) (depth)
2" if telescope see back.
(size)
- (5) screen 10' 320
(length) (depth to top)
2 S. Steel
(size) (material)
- (6) pump 1/2 10
(HP) (yield gpm)
Elec
(type power)
- (7) electric log No
(yes or no)

(organization running log)

(8) how well bottom plugged BW Valve

Miss. Board of Water Comm.


DRILLERS REMARKS:

APR 10 1979

RECEIVED

If well telescopes please sketch and show depths.

GROUND LEVEL

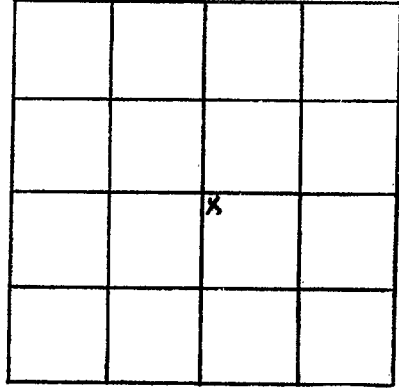

SECTION 2

Please indicate well location X.

ADDITIONAL INFORMATION

A series of horizontal lines for writing additional information, starting below the 'ADDITIONAL INFORMATION' header and extending down to the bottom of the page.

If more than one screen, show locations of each on sketch.