

Pearl Ri.
W 2024
9-17-79

MISSISSIPPI
 BOARD OF WATER COMMISSIONERS
 416 North State Street
 Jackson, Mississippi 39201

WATER WELL DRILLERS LOG

Sept. 17 1979 Duncan Well Drilling Pearl River
 date well completed firm name county well located

LANDOWNER: <u>Gladder Burch</u> <u>Rt. 1 Box 205</u>	description of formations encountered	from	to
<u>Picayune, Ms</u> (mailing address)	<u>Clay</u>	<u>0</u>	<u>110</u>
WELL LOCATION: sec <u>24</u> T <u>6</u> N R <u>17</u> E <u>5</u> miles <u>SW</u> of <u>Picayune</u> (distance) (direction) (nearest town)	<u>Blue clay</u>	<u>110</u>	<u>208</u>
WELL PURPOSE: <u>Home</u> (home, irrigation, municipal, industrial)	<u>Fine Sand</u>	<u>208</u>	<u>240</u>
WELL COMPLETION DATA: (1) diameter (inches) <u>2"</u>	<u>Coarse Sand</u>	<u>240</u>	<u>252</u>
(2) total depth (feet) <u>252 ft.</u>			
(3) static water level (feet) <u>50'</u> <u>below</u> top of ground.			
(4) casing <u>PVC</u> , <u>242'</u> (material) (depth)			
(5) screen <u>10'</u> , <u>242'</u> (length) (depth to top)			
(6) pump <u>1</u> , <u>11</u> (HP) (yield gpm)			
<u>electric</u> (type power)			
(7) electric log _____ (yes or no)			
(8) how well bottom plugged <u>Sand</u>			
DRILLERS REMARKS: <u>Shark</u>			


DEPT. OF NATURAL RESOURCES
 BUREAU OF LAND & WATER RESOURCES

JAN 15 1980

RECEIVED

If well telescopes please sketch and show depths.

GROUND LEVEL

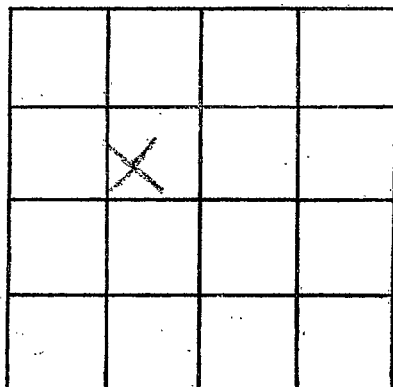

SECTION 24

Please indicate well location X.

ADDITIONAL INFORMATION

If more than one screen, show locations of each on sketch.