

PEARL RIVER  
W2025  
12-21-79

MISSISSIPPI  
 BOARD OF WATER COMMISSIONERS  
 416 North State Street  
 Jackson, Mississippi 39201  
 WATER WELL DRILLERS LOG

8  
 CODED

12-21 date well completed      799 PENTON Well Serv. firm name      Pearl River county well located

LANDOWNER: Ernest Furr  
Rt 4  
Picayune, MS.  
 (mailing address)

| description of formations encountered | from                | to         |
|---------------------------------------|---------------------|------------|
|                                       | <u>Surface Clay</u> | <u>0</u>   |
| <u>Sand</u>                           | <u>20</u>           | <u>85</u>  |
| <u>Blue Clay</u>                      | <u>85</u>           | <u>380</u> |
| <u>Sand</u>                           | <u>380</u>          | <u>438</u> |

WELL LOCATION:  
 sec. 27 T 7 N R 17 E  
1/2 miles South of Picayune  
 (distance) (direction) (nearest town)

WELL PURPOSE: Home  
 (home, irrigation, municipal, industrial)

- WELL COMPLETION DATA:
- diameter (inches) 2"
  - total depth (feet) 438'
  - static water level (feet) 20' below above top of ground.
  - casing Galv (material), 428' (depth)  
2" (size) if telescope see back.
  - screen 10' (length), 428' (depth to top)  
2" (size), S. Steel (material)
  - pump OWN (HP), (yield gpm)  
 (type power)
  - electric log No (yes or no)  
 (organization running log)
  - how well bottom plugged Blw Valve

DRILLERS REMARKS:


DEPT. OF NATURAL RESOURCES  
 BUREAU OF LAND & WATER RESOURCES

FEB -7 1980

RECEIVED

If well telescopes please sketch and show depths.

GROUND LEVEL

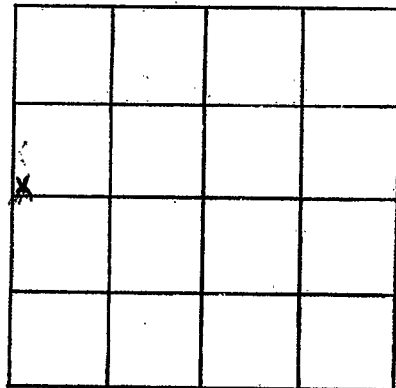

SECTION 27

Please indicate well location X.

ADDITIONAL INFORMATION

If more than one screen,  
show locations of each on sketch.