

Pearl River
W 22nd
12-26-79

MISSISSIPPI
 BOARD OF WATER COMMISSIONERS
 416 North State Street
 Jackson, Mississippi 39201

CODED

WATER WELL DRILLERS LOG

12-26 1979 Penton Well Serv Pearl River
 date well completed firm name county well located

LANDOWNER: <u>Bill Hursey</u>	description of formations encountered	from	to
<u>Rt 4</u>	<u>Surface Clay</u>	<u>0</u>	<u>20</u>
<u>Picayune, MS.</u> (mailing address)	<u>Sand</u>	<u>20</u>	<u>80</u>
WELL LOCATION:	<u>Blue Clay</u>	<u>80</u>	<u>240</u>
sec. <u>34</u> T. <u>7</u> N R. <u>17</u> E S <u>0</u> miles <u>East</u> of <u>Nicholson</u> (distance) (direction) (nearest town)	<u>Sand</u>	<u>240</u>	<u>283</u>
WELL PURPOSE: <u>Home</u> (home, irrigation, municipal, industrial)			
WELL COMPLETION DATA:			
(1) diameter (inches) <u>2"</u>			
(2) total depth (feet) <u>283'</u>			
(3) static water level (feet) <u>16'</u> below top of ground.			
(4) casing <u>Galv.</u> , <u>273'</u> (material) (depth) <u>2"</u> if telescope see back. (size)			
(5) screen <u>10"</u> , <u>273'</u> (length) (depth to top)			
<u>2"</u> , <u>S. Steel</u> (size) (material)			
(6) pump <u>1/2</u> , <u>10</u> (HP) (yield gpm)			
<u>Flec.</u> (type power)			
(7) electric log <u>No</u> (yes or no)			
(organization running log)			
(8) how well bottom plugged <u>Bw Caloz</u>			
DRILLERS REMARKS:			


DEPT. OF NATURAL RESOURCES
 BUREAU OF LAND & WATER RESOURCES

FEB -7 1981

RECEIVED

If well telescopes please sketch and show depths.

GROUND LEVEL

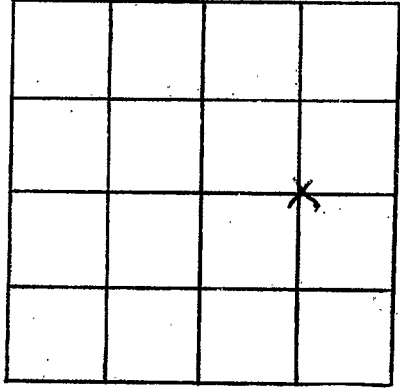

SECTION 34

Please indicate well location X.

ADDITIONAL INFORMATION

If more than one screen,
show locations of each on sketch.