

Pearl River
Wood
1-19-79

MISSISSIPPI
 BOARD OF WATER COMMISSIONERS
 416 North State Street
 Jackson, Mississippi 39201

WATER WELL DRILLERS LOG

1-19-79 date well completed BOUNCEY WATER WELL DRILLING firm name Pearl River county well located

LANDOWNER: Kick Malone
Station
city
 (mailing address)

WELL LOCATION:
 sec 10 T 6 N R 17 E
In P. Community
 (distance) miles (direction) of (nearest town)

WELL PURPOSE: for school
 (home, irrigation, municipal, industrial)

WELL COMPLETION DATA:
 (1) diameter (inches) 2
 (2) total depth (feet) 64
 (3) static water level (feet) 30 below top of ground.
 (4) casing PVC 64 (material) (depth)
 (size) If telescope see back.
 (5) screen 5 59 (length) (depth to top)
 (size) (material) 2 PVC
 (6) pump 1/2 (HP) 7 (yield gpm)
 (type power) AC
 (7) electric log (yes or no)
 (organization running log)
 (8) how well bottom plugged (check)

description of formations encountered	from	to
<u>Clay</u>	<u>0</u>	<u>20</u>
<u>S&S</u>	<u>20</u>	<u>30</u>
<u>Clay</u>	<u>30</u>	<u>42</u>
<u>S&S</u>	<u>42</u>	<u>64</u>

Miss. Board of Water Comm.


APR 2 - 1979

RECEIVED

DRILLERS REMARKS:

If well telescopes please sketch and show depths.

GROUND LEVEL

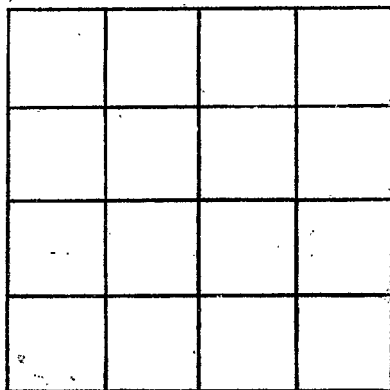

SECTION _____

Please indicate well location X.

ADDITIONAL INFORMATION

If more than one screen,
show locations of each on sketch.