

Pearl R.  
W 2028  
7-7-79

MISSISSIPPI  
 BOARD OF WATER COMMISSIONERS  
 416 North State Street  
 Jackson, Mississippi 39201

WATER WELL DRILLERS LOG

July 7 1979 Succor Well Drilling Pearl River  
 date well completed firm name county well located

LANDOWNER: Carl A. Estes

Rte # 2 Box 456  
Picayune, Ms. 39466  
 (mailing address)

WELL LOCATION:

sec 14 T 6 N R 17 E  
3 miles W. of Picayune  
 (distance) (direction) (nearest town)

WELL PURPOSE: Home  
 (home, irrigation, municipal, industrial)

WELL COMPLETION DATA:

- (1) diameter (inches) 2"
- (2) total depth (feet) 340 ft.
- (3) static water level (feet) 30' below top of ground.
- (4) casing PVC, 330'  
 (material) (depth)
- (size) If telescope see back.
- (5) screen 10', 330'  
 (length) (depth to top)
- 2", pvc.  
 (size) (material)
- (6) pump 1 10  
 (HP) (yield gpm)
- electric  
 (type power)
- (7) electric log \_\_\_\_\_  
 (yes or no)

(organization running log)

(8) how well bottom plugged Sand  
Mark

DRILLERS REMARKS:

description of formations encountered

from to

|             |     |     |
|-------------|-----|-----|
| top sand    | 0   | 18  |
| white clay  | 18  | 90  |
| Blue clay   | 90  | 283 |
| fine sand   | 283 | 325 |
| course sand | 325 | 330 |


DEPT. OF NATURAL RESOURCES  
 BUREAU OF LAND & WATER RESOURCES

JAN 14 1980

RECEIVED

If well telescopes please sketch and show depths.

GROUND LEVEL

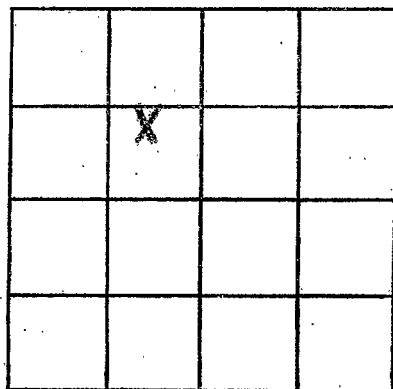

SECTION 14

Please indicate well location X.

ADDITIONAL INFORMATION

If more than one screen, show locations of each on sketch.