

MISSISSIPPI DEPARTMENT OF NATURAL RESOURCES

Bureau of Land and Water Resources

Southport Mall

P.O. Box 10631

Jackson, Mississippi 39209

WATER WELL DRILLERS LOG

Pearl River  
W 2022A  
4-26-80

4-26 1980 Periton Well Serv Pearl River  
 date well completed firm name county well located

LANDOWNER: <u>Lzdner Elec.</u>	description of formations encountered	from	to
<u>Hwy-11 N.</u>	<u>Surface Clay</u>	<u>0</u>	<u>20</u>
<u>Picayune MS.</u> (mailing address)	<u>Sand</u>	<u>20</u>	<u>55</u>
<b>WELL LOCATION:</b>			
sec. <u>9</u> T. <u>6</u> N. R. <u>17</u> W.			
<u>0</u> miles <u>North</u> of <u>Picayune</u>			
(distance) (direction) (nearest town)			
<b>WELL PURPOSE:</b> <u>Air Cond.</u> (home, irrigation, municipal, industrial)			
<b>WELL COMPLETION DATA:</b>			
(1) diameter (inches) <u>2</u>			
(2) total depth (feet) <u>55</u>			
(3) static water level (feet): <u>8'</u> below top of ground.			
(4) casing <u>PVC</u> <u>50'</u>			
(material) (depth)			
<u>2</u> if telescope see back.			
(size)			
(5) screen <u>5'</u> <u>50'</u>			
(length) (depth to top)			
<u>2</u> <u>PVC</u>			
(size) (material)			
(6) pump <u>3/4</u> <u>13</u>			
(HP) (yield gpm)			
<u>Elec</u>			
(type power)			
(7) electric log <u>No</u>			
(yes or no)			
(organization running log)			
(8) how well bottom plugged <u>BW 1/2/ve</u>			
<b>DRILLERS REMARKS:</b>			


DEPT. OF NATURAL RESOURCES  
 BUREAU OF LAND & WATER RESOURCES

JUN 3 - 1980

RECEIVED

If well telescopes please  
sketch and show depths.

GROUND LEVEL

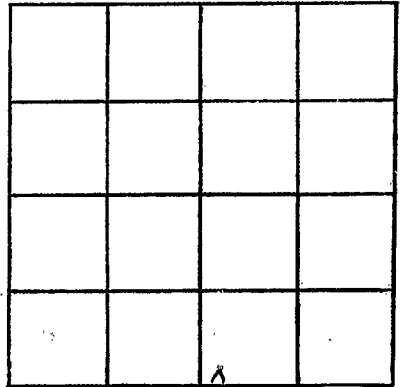

SECTION 9

Please indicate well location X.

ADDITIONAL INFORMATION

If more than one screen,  
show locations of each on sketch.