

Pearl River  
W 2030  
1-12-80

MISSISSIPPI  
 BOARD OF WATER COMMISSIONERS  
 416 North State Street  
 Jackson, Mississippi 39201

CODED

WATER WELL DRILLERS LOG

1-12-80 19 PENTON Well Service Pearl River  
 date well completed firm name county well located

LANDOWNER: David Harris  
Rt 4  
Picayune, ms.  
 (mailing address)  
 WELL LOCATION:  
 sec. 28 T. 7 N. R. 17 E  
 S W  
1 miles SW of Picayune  
 (distance) (direction) (nearest town)

description of formations encountered	from	to
Clay	0	30
Sand + Gravel	30	100
Blue Clay	100	420
Sand	420	487

WELL PURPOSE: home  
 (home, irrigation, municipal, industrial)

- WELL COMPLETION DATA:
- (1) diameter (inches) 2"
  - (2) total depth (feet) 487'
  - (3) static water level (feet) 19' below above top of ground.
  - (4) casing Galv. 477'  
 (material) (depth)  
2" if telescope see back.  
 (size)
  - (5) screen 10' 477'  
 (length) (depth to top)  
2" S.Steel  
 (size) (material)
  - (6) pump 1 20  
 (HP) (yield gpm)  
Elec  
 (type power)
  - (7) electric log NO  
 (yes or no)

(organization running log)  
 (8) how well bottom plugged Bit Valve

DRILLERS REMARKS:


DEPT. OF NATURAL RESOURCES  
 BUREAU OF LAND & WATER RESOURCES

FEB -7 1980

RECEIVED

If well telescopes please sketch and show depths.

GROUND LEVEL

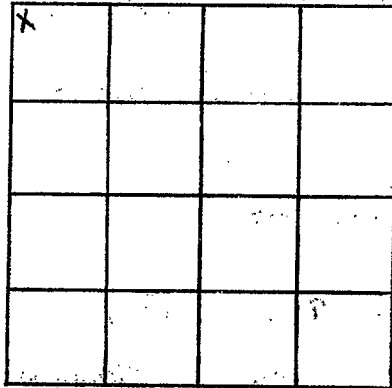

SECTION 28

Please indicate well location X.

ADDITIONAL INFORMATION

If more than one screen,  
show locations of each on sketch.