

Pearl River
 W 2032
 5/23/80

MISSISSIPPI
 BOARD OF WATER COMMISSIONERS
 416 North State Street
 Jackson, Mississippi 39201

WATER WELL DRILLERS LOG

Pooney Water Well
 Drilling

Pearl River

3-13

1980

date well completed

firm name

county well located

LANDOWNER: Leslie Travis

City -

(mailing address)

description of formations encountered

from

to

clay -

0 10

sd - gravel -

10 30

WELL LOCATION:

sec. 1 T 6 N R 17 E
 City of Picayune
 (distance) (direction) (nearest town)

WELL PURPOSE: Heat Pump
 (home, irrigation, municipal, industrial)

WELL COMPLETION DATA:

- (1) diameter (inches) 2
- (2) total depth (feet) 30
- (3) static water level (feet) 14 below top of ground
- (4) casing (material) PVC (depth) 25
 2 if telescope see back. (size)
- (5) screen (length) 5 (depth to top) 25
 2 (size) PVC (material)
- (6) pump (HP) 3/4 (yield gpm) 5
 AC-220 (type power)
- (7) electric log (yes or no)

(organization running log)

(8) how well bottom plugged

DRILLERS REMARKS:


DEPT. OF NATURAL RESOURCES
 BUREAU OF LAND & WATER RESOURCES

MAY 19 1980

RECEIVED

If well telescopes please sketch and show depths.

GROUND LEVEL

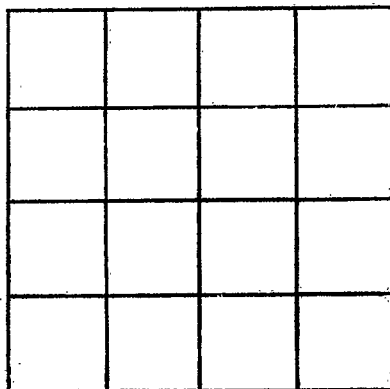

SECTION _____

Please indicate well location X.

ADDITIONAL INFORMATION

If more than one screen, show locations of each on sketch.