

PEARL RIVER

MISSISSIPPI
BOARD OF WATER COMMISSIONERS
416 North State Street
Jackson, Mississippi 39201

W 2034

6-10-80

6-15

WATER WELL DRILLERS LOG
BOUNCY WATER WELL DRILLING

Pearl River

date well completed

firm name

county well located

LANDOWNER: Wooden Spinn
Pearl River Oil Co -
Pickynone, Ms.
(mailing address)

description of formations encountered	from	to
Clay	0	8
SD	8	30
Clay	30	34
SD	34	55
gravel	55	64

WELL LOCATION:
sec 27 T 6 N R 17 E
S W
City (distance) (direction) of City (nearest town)

WELL PURPOSE: AC
(home, irrigation, municipal, industrial)

- WELL COMPLETION DATA:
- (1) diameter (inches) 2
 - (2) total depth (feet) 64
 - (3) static water level (feet) 22 below top of ground.
 - (4) casing PVC 54
(material) (depth)
2 If telescope see back.
(size)
 - (5) screen 10 54
(length) (depth to top)
2 (size) PVC (material)
 - (6) pump 1 1/2 15
(HP) (yield gpm)
AC 300 (type power)
 - (7) electric log yes (yes or no)
(organization running log)
 - (8) how well bottom plugged

DRILLERS REMARKS:


DEPT. OF NATURAL RESOURCES
BUREAU OF LAND & WATER RESOURCES

JUN 25 1980

RECEIVED

If well telescopes please sketch and show depths.

GROUND LEVEL

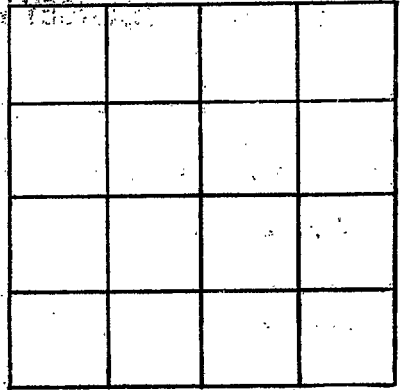

SECTION _____

Please indicate well location X.

ADDITIONAL INFORMATION

If more than one screen, show locations of each on sketch.