

PEARL RIVER

MISSISSIPPI  
BOARD OF WATER COMMISSIONERS  
416 North State Street  
Jackson, Mississippi 39201

WATER WELL DRILLERS LOG

W 2035  
6-19-80

6-19-80 date well completed  
BOUNCY WATER WELL DRILLING firm name  
Pearl River county well located

LANDOWNER: Murray Bellinger

Description of formations encountered

from to

Nicholson

MS,

(mailing address)

Top - 0 8  
Blk sd - 8 35  
SD/Agard - 35 52

WELL LOCATION:

sec. 27 T 4 N R 17 E  
S W  
2 miles S of Picayune  
(distance) (direction) (nearest town)

WELL PURPOSE: IRR  
(home, irrigation, municipal, industrial)

WELL COMPLETION DATA:

- (1) diameter (inches) 2
- (2) total depth (feet) 32
- (3) static water level (feet) 15 below top of ground
- (4) casing PVC 47  
(material) (depth)  
2 (size) If telescope see back.
- (5) screen 47  
(length) (depth to top)  
2 PVC  
(size) (material)
- (6) pump 3/4 12  
(HP) (yield gpm)  
AC 2200  
(type power)
- (7) electric log (yes or no) /  
(organization running log) /
- (8) how well bottom plugged

DEPT. OF NATURAL RESOURCES  
BUREAU OF LAND & WATER RESOURCES


JUN 25 1980

RECEIVED

DRILLERS REMARKS:

If well telescopes please sketch and show depths.

GROUND LEVEL

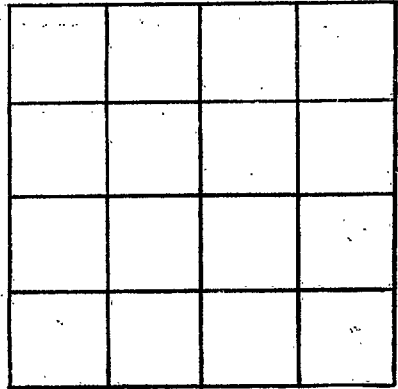

SECTION \_\_\_\_\_

Please indicate well location X.

ADDITIONAL INFORMATION

If more than one screen, show locations of each on sketch.