

PEARL RIVER

W 2030

6/26/80

6-265

MISSISSIPPI  
BOARD OF WATER COMMISSIONERS  
416 North State Street  
Jackson, Mississippi 39201

WATER WELL DRILLERS LOG

SPUNCEY WATER WELL DRILLING

PEARL RIVER

date well completed

firm name

county well located

LANDOWNER:

Arvey Country  
Jackson Landing Rd.  
P. A. Gwyn, MS.  
(mailing address)

description of formations encountered

from

to

clay  
sand  
gravel

0 5  
5 32  
5 57

WELL LOCATION:

sec 20 T 7 N R 6 E  
S W  
1/2 miles W of P. A. Gwyn  
(distance) (direction) (nearest town)

WELL PURPOSE:

(home, irrigation, municipal, industrial)

WELL COMPLETION DATA:

- (1) diameter (inches) 2
- (2) total depth (feet) 57
- (3) static water level (feet) 22 below top of ground
- (4) casing PVC 52  
(material) (depth)
- 2 if telescope see back.  
(size)
- (5) screen 5 47  
(length) (depth to top)
- 2 PVC  
(size) (material)
- (6) pump 1/2 8  
(HP) (yield gpm)
- AC  
(type power)
- (7) electric log /  
(yes or no)

(organization running log)

(8) how well bottom plugged Seal

DEPT. OF NATURAL RESOURCES  
BUREAU OF LAND & WATER RESOURCES


AUG 11 1980

DRILLERS REMARKS:

RECEIVED

If well telescopes please sketch and show depths.

GROUND LEVEL

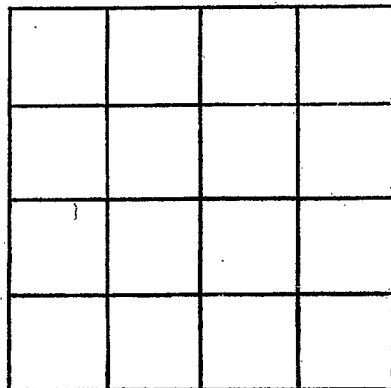

SECTION \_\_\_\_\_

Please indicate well location X.

ADDITIONAL INFORMATION

If more than one screen, show locations of each on sketch.