

PEARL RIVER
W 2037
10/2/80
10-2

MISSISSIPPI
 BOARD OF WATER COMMISSIONERS
 416 North State Street
 Jackson, Mississippi 39201



WATER WELL DRILLERS LOG

BOUNCEY WATER WELL DRILLING

date well completed

firm name

county well located

LANDOWNER: Russel G. Chauvin
Hickory Ridge Estates
 (mailing address)

description of formations encountered

from

to

Top
SD gravel — 6 48

WELL LOCATION:

sec 28 T 7 N R 18 E
2 miles W of Picayune
 (distance) (direction) (nearest town)


WELL PURPOSE: AC Heat Pump
 (home, irrigation, municipal, industrial)

WELL COMPLETION DATA:

- (1) diameter (inches) 2
- (2) total depth (feet) 48
- (3) static water level (feet) 22 below top of ground.
- (4) casing PVC 43
 (material) (depth)
2 if telescope see back.
 (size)
- (5) screen 5 43
 (length) (depth to top)
2 PVC
 (size) (material)
- (6) pump 3/4 12
 (HP) (yield gpm)
AC
 (type power)
- (7) electric log
 (yes or no)


 (organization running log)
- (8) how well bottom plugged

DRILLERS REMARKS:

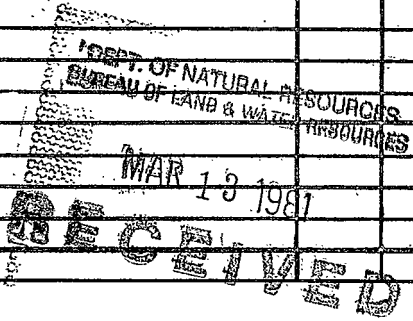

If well telescopes please sketch and show depths.

GROUND LEVEL

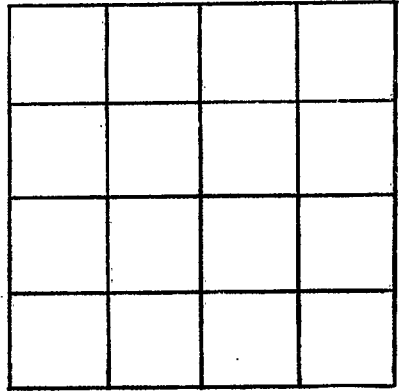

SECTION _____

Please indicate well location X.

ADDITIONAL INFORMATION

If more than one screen, show locations of each on sketch.