


If well telescopes please sketch and show depths.

Located at
802 - 3rd Ave -
Pineyview, MS.

GROUND LEVEL

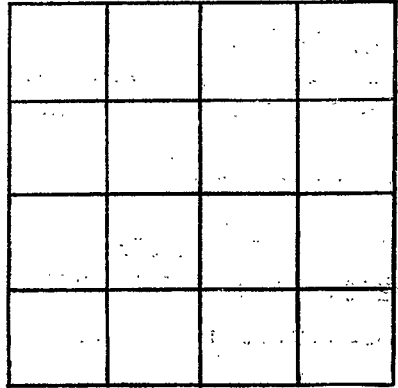

SECTION ?

Please indicate well location X.

ADDITIONAL INFORMATION

Lined area for additional information, consisting of approximately 20 horizontal lines.

If more than one screen, show locations of each on sketch.