

MISSISSIPPI DEPARTMENT OF NATURAL RESOURCES

Bureau of Land and Water Resources

Southport Mall

P.O. Box 10631

Jackson, Mississippi 39209

WATER WELL DRILLERS LOG

BUD PENTON & SON  
WATER WELL SERVICE

ROUTE 3 BOX 41

CARRIAGE, MS 39426

PHONE 798-5324

*Pearl River*

Pearl River  
W 2035  
6-26-81

6-26- 19 81  
date well completed

county well located

LANDOWNER: Alford Mills  
Prague, Ms.  
(mailing address)

description of formations encountered	from	to
<u>Grey Silt</u>	<u>0</u>	<u>10</u>
<u>White Sand</u>	<u>10</u>	<u>59'</u>

WELL LOCATION:  
sec. 10 T. 6 N. R. 10 E.  
miles (distance) off (direction) of (nearest town) Prague

WELL PURPOSE: Use for irrigation  
(home, irrigation, municipal, industrial)

WELL COMPLETION DATA:

- (1) diameter (inches) 2
- (2) total depth (feet) 59
- (3) static water level (feet) 10 below top of ground.
- (4) casing PVC 49  
(material) (depth)
- (size) if telescope see back.
- (5) screen 10 49  
(length) (depth to top)
- (size) 2 (material) PVC
- (6) pump 1/2 500  
(HP) (yield gpm)
- (type power) elec
- (7) electric log \_\_\_\_\_  
(yes or no)

(organization running log)

(8) how well bottom plugged Yes

DRILLERS REMARKS:


DEPT. OF NATURAL RESOURCES  
BUREAU OF LAND & WATER RESOURCES

NOV 9 - 1981

RECEIVED

If well telescopes please sketch and show depths.

GROUND LEVEL

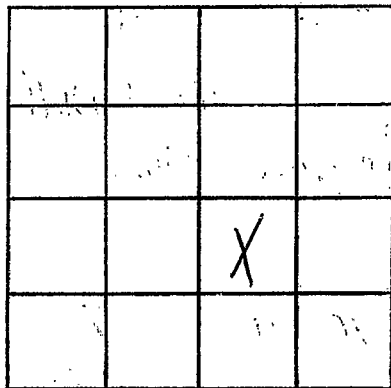

SECTION \_\_\_\_\_

Please indicate well location X.

ADDITIONAL INFORMATION

If more than one screen,  
show locations of each on sketch.