


PEARL RIVER
 W 2040
 1/20/81
 1-22
 date well completed

MISSISSIPPI
 BOARD OF WATER COMMISSIONERS
 416 North State Street
 Jackson, Mississippi 39201

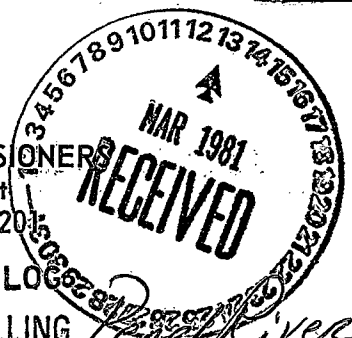

WATER WELL DRILLERS LOG

BOUNCY WATER WELL DRILLING
 firm name
 Pearl River
 county well located

| LANDOWNER: <u>Richard Stackstill</u> | description of formations encountered | from | to |
|--|---------------------------------------|-----------|-----------|
| <u>Picayune, Micholton</u> (mailing address) | | | |
| WELL LOCATION: sec. <u>37</u> T. <u>6</u> N. R. <u>17</u> E <u>2</u> miles <u>E</u> of <u>Micholton</u> (distance) (direction) (nearest town) | <u>TOP</u> | <u>0</u> | <u>10</u> |
| WELL PURPOSE: <u>AC Heat</u> (home, irrigation, municipal, industrial) | <u>SD</u> | <u>10</u> | <u>35</u> |
| WELL COMPLETION DATA: (1) diameter (inches) <u>2</u> | <u>SD Gravel</u> | <u>35</u> | <u>50</u> |
| (2) total depth (feet) <u>50</u> | | | |
| (3) static water level (feet) <u>22</u> below top of ground | | | |
| (4) casing <u>PVC</u> <u>45</u> (material) (depth) <u>2</u> If telescope see back. (size) | | | |
| (5) screen <u>5</u> <u>45</u> (length) (depth to top) <u>2</u> <u>PVC</u> (size) (material) | | | |
| (6) pump <u>3/4</u> <u>0</u> (HP) (yield gpm) <u>AC</u> (type power) | | | |
| (7) electric log <u>yes or no</u> (organization running log) | | | |
| (8) how well bottom plugged | | | |
| DRILLERS REMARKS: | | | |


DEPT. OF NATURAL RESOURCES
 BUREAU OF LAND & WATER RESOURCES

MAR 13 1981



If well telescopes please sketch and show depths.

GROUND LEVEL

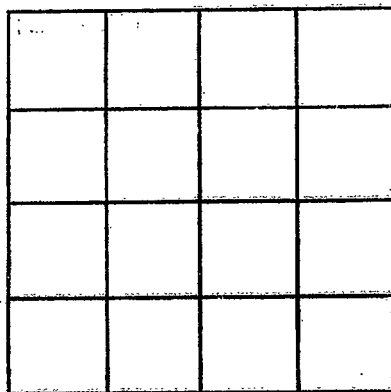

SECTION _____

Please indicate well location X.

ADDITIONAL INFORMATION

If more than one screen, show locations of each on sketch.