

Pearl River
 W 2024
 4-1-81

MISSISSIPPI
 BOARD OF WATER COMMISSIONERS
 416 North State Street
 Jackson, Mississippi 39201

WATER WELL DRILLERS LOG

4-1 1981 Penton Well Serv Pearl River
 date well completed firm name county well located

LANDOWNER: Don Frierson

description of formations
 encountered

from to

Rt.

Picayune, MS.
 (mailing address)

<u>Surface clay</u>	<u>0</u>	<u>30</u>
<u>Sand</u>	<u>30</u>	<u>95</u>
<u>Blue clay</u>	<u>95</u>	<u>360</u>
<u>Sand</u>	<u>360</u>	<u>454</u>

WELL LOCATION:

sec. 35 T. 67 N. R. 17 E
 S W
2 miles S of Picayune
 (distance) (direction) (nearest town)

WELL PURPOSE: Home
 (home, irrigation, municipal, industrial)

WELL COMPLETION DATA:

- diameter (inches) 2
- total depth (feet) 454
- static water level (feet) 21 below top of ground.
- casing Galv., 444
 (material) (depth)
2 if telescope see back.
 (size)
- screen 10', 444
 (length) (depth to top)
2, S. Steel
 (size) (material)
- pump 1/2, 9
 (HP) (yield gpm)
Elec
 (type power)
- electric log No
 (yes or no)

(organization running log)

(8) how well bottom plugged B W

DRILLERS REMARKS:


DEPT. OF NATURAL RESOURCES
 BUREAU OF LAND & WATER RESOURCES

MAY -7 1981

RECEIVED

If well telescopes please
sketch and show depths.

GROUND LEVEL

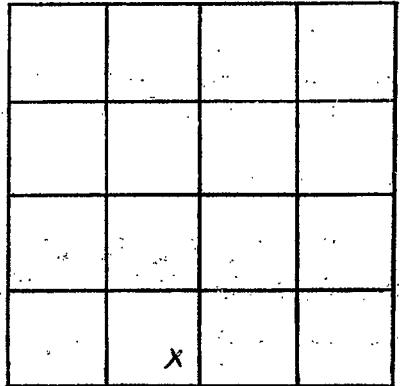

SECTION 35

Please indicate well location X.

ADDITIONAL INFORMATION

If more than one screen,
show locations of each on sketch.