

MISSISSIPPI DEPARTMENT OF NATURAL RESOURCES

Bureau of Land and Water Resources

Southport Mall

P.O. Box 10631

Jackson, Mississippi 39209

WATER WELL DRILLERS LOG

PEARL RIVER  
W 2012  
5/7/81  
5/1/81

date well completed 5/1/81 1981 Bud Penton firm name Pearl River county well located

LANDOWNER: W. H. Service

description of formations encountered	from	to
<u>white shale</u>	<u>0</u>	<u>30</u>
<u>white sand Rock</u>	<u>30</u>	<u>65</u>
<u>blue shale</u>	<u>65</u>	<u>300</u>
<u>gray sand</u>	<u>300</u>	<u>360</u>

R F - 6 Pinnacle  
Inside Road  
(mailing address)

WELL LOCATION:  
sec. 74 T 7 N R 18 E  
S W  
2 miles West of Pinnacle  
(distance) (direction) (nearest town)

WELL PURPOSE: Home  
(home, irrigation, municipal, industrial)

WELL COMPLETION DATA:

- (1) diameter (inches) 2"
- (2) total depth (feet) 360
- (3) static water level (feet) 10' below above top of ground.
- (4) casing PVC 360  
(material) (depth)

         if telescope see back.  
(size)

- (5) screen 2x10 350  
(length) (depth to top)  
10 PVC  
(size) (material)


- (6) pump 1/2 45-6  
(HP) (yield gpm)  
Elc.  
(type power)

- (7) electric log no.  
(yes or no)

          
(organization running log)

- (8) how well bottom plugged hard

DRILLERS REMARKS:

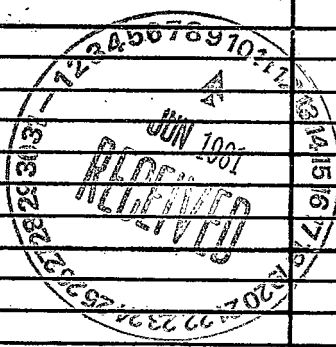

If well telescopes please sketch and show depths.

GROUND LEVEL

		X	

SECTION \_\_\_\_\_

Please indicate well location X.

ADDITIONAL INFORMATION

If more than one screen,  
show locations of each on sketch.