

MISSISSIPPI DEPARTMENT OF NATURAL RESOURCES

Bureau of Land and Water Resources

Southport Mall

P.O. Box 10631

Jackson, Mississippi 39209

WATER WELL DRILLERS LOG

Pearl River
 W 2043
 9-16-81

9-16 1981 date well completed
 ROUNCEY WATER WELL DRILLING firm name
 Pearl River county well located


LANDOWNER:	description of formations encountered	from	to
Dallas Penton City	Top	0	8
P. J. Cayton (mailing address)	SD	8	30
WELL LOCATION: sec. 2 T 6 N R 17 E City S of City W	Clay grey	30	42
(distance) (direction) (nearest town)	SD good shallow	42	65

WELL PURPOSE: AC Heat
 (home, irrigation, municipal, industrial)

- WELL COMPLETION DATA:
- (1) diameter (inches) 2
 - (2) total depth (feet) 65
 - (3) static water level (feet) 24 below top of ground
 - (4) casing PVC 55 (material) (depth)
2 (size) if telescope see back.
 - (5) screen 10 55 (length) (depth to top)
2 PVC (size) (material)
 - (6) pump 12 10 (HP) (yield gpm)
AC 220V (type power)
 - (7) electric log (yes or no)
 - (organization running log)
 - (8) how well bottom plugged Sealed

DEPT. OF NATURAL RESOURCES
 BUREAU OF LAND & WATER RESOURCES


SEP 18 1981
 RECEIVED

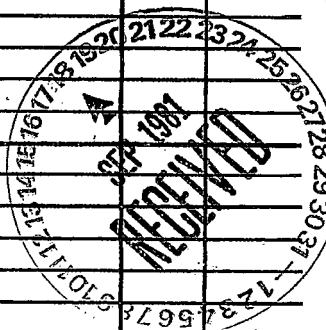

DRILLERS REMARKS:

If well telescopes please sketch and show depths.

GROUND LEVEL

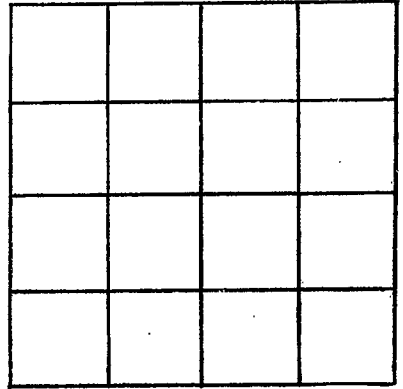

SECTION _____

Please indicate well location X.

ADDITIONAL INFORMATION

If more than one screen,
show locations of each on sketch.