

Pearl River
 W 2044
 9-18-81

MISSISSIPPI
 BOARD OF WATER COMMISSIONERS
 416 North State Street
 Jackson, Mississippi 39201

WATER WELL DRILLERS LOG

9-18 19 81 Penton Well Serv Pearl River
 date well completed firm name county well located

LANDOWNER: Jack Honez
 Nicholson, MS.
 (mailing address)

WELL LOCATION:
 sec 28 T 7 N R 17 E
 S W
 1 miles S.W. of Picayune
 (distance) (direction) (nearest town)

WELL PURPOSE: HOME
 (home, irrigation, municipal, industrial)

- WELL COMPLETION DATA:
- (1) diameter (inches) 2
 - (2) total depth (feet) 324
 - (3) static water level (feet) 25 below top of ground.
 - (4) casing PVC 314 (material) (depth)
 2 (size) if telescope see back.
 - (5) screen 10' 314 (length) (depth to top)
 2 PVC (size) (material)
 - (6) pump 1/2 9 (HP) (yield gpm)
 Elec (type power)
 - (7) electric log NO (yes or no)
 - (8) how well bottom plugged BU Valve

DRILLERS REMARKS:

description of formations encountered	from	to
Surface Clay	0	15
Sand	15	100
Clay	100	220
Sand	220	324


DEPT. OF NATURAL RESOURCES
 BUREAU OF LAND & WATER RESOURCES

OCT 19 1981

RECEIVED

If well telescopes please sketch and show depths.

GROUND LEVEL

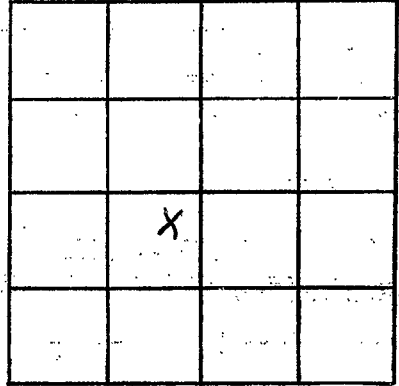

SECTION 28

Please indicate well location X.

ADDITIONAL INFORMATION

If more than one screen, show locations of each on sketch.