

Pearl River
W 2045
9-15-81

MISSISSIPPI
 BOARD OF WATER COMMISSIONERS
 416 North State Street
 Jackson, Mississippi 39201

WATER WELL DRILLERS LOG

9-15 1981 Penton Well Serv Pearl River
 date well completed firm name county well located

LANDOWNER: Terry Asher
Nicholson, MS.
 (mailing address)

description of formations encountered	from	to
Surface Clay	0	30
Sand	30	100
Clay	100	220
Sand	220	290

WELL LOCATION: 6
 sec. 28 T 2 N R 10 E
1 miles SW of Picayune
 (distance) (direction) (nearest town)

WELL PURPOSE: Home
 (home, irrigation, municipal, industrial)

- WELL COMPLETION DATA:
- (1) diameter (inches) 2
 - (2) total depth (feet) 290
 - (3) static water level (feet) 20 below top of ground.
 - (4) casing PVC, 280,
 (material) (depth)
2 If telescope see back.
 (size)
 - (5) screen 10', 280
 (length) (depth to top)
2, PVC
 (size) (material)
 - (6) pump 3/4, 700
 (HP) (yield gpm)
Elec 9pk
 (type power)
 - (7) electric log No
 (yes or no)

(organization running log)
 (8) how well bottom plugged BW Valve


DRILLERS REMARKS:

DEPT. OF NATURAL RESOURCES
 BUREAU OF LAND & WATER RESOURCES

OCT 19 1981
 RECEIVED

If well telescopes please sketch and show depths.

GROUND LEVEL

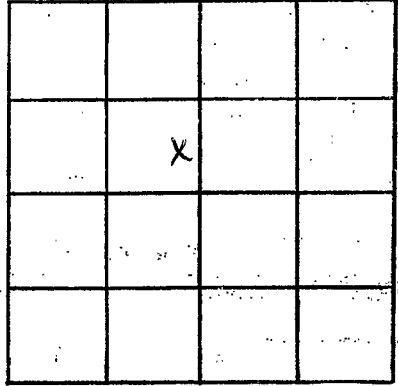

SECTION 28

Please indicate well location X.

ADDITIONAL INFORMATION

If more than one screen, show locations of each on sketch.