

MISSISSIPPI DEPARTMENT OF NATURAL RESOURCES

Bureau of Land and Water Resources

Southport Mall

P.O. Box 10631

Jackson, Mississippi 39209

WATER WELL DRILLERS LOG

Pearl River
W 2046
9-28-81

9-28 1981

Bad Planters & Son

P.R

date well completed

firm name

county well located

LANDOWNER: David Oliver

description of formations encountered

from

to

Jelly Stone Park - ms.

gray shale	0	20
white sand	20	40
blue shale	40	135
blue sand	135	135
blue shale	135	160
blue sand	160	230

(mailing address)

WELL LOCATION:

sec. 6 T. 6 N. R. 17 E. S. 1
1 miles E of Prigum
(distance) (direction) (nearest town)

WELL PURPOSE: home
(home, irrigation, municipal, industrial)

WELL COMPLETION DATA:

- (1) diameter (inches) 2
- (2) total depth (feet) 230
- (3) static water level (feet) 42 below above top of ground.
- (4) casing PVC 230
(material) (depth)
- 10' if telescope see back.
(size)
- (5) screen 220
(length) (depth to top)
- 2" PVC
(size) (material)
- (6) pump 1/2 600
(HP) (yield gpm)
- elec
(type power)
- (7) electric log
(yes or no)

(organization running log)

(8) how well bottom plugged

DRILLERS REMARKS:

DEPT. OF NATURAL RESOURCES
BUREAU OF LAND & WATER RESOURCES


NOV 9 - 1981

RECEIVED

Road Section

If well telescopes please sketch and show depths.

GROUND LEVEL

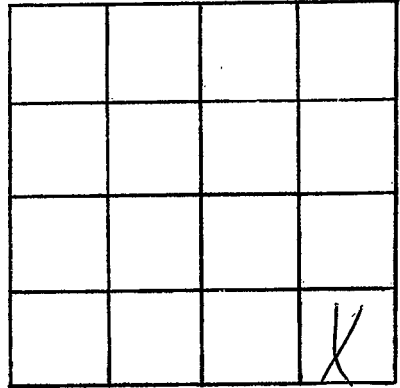

SECTION _____

Please indicate well location X.

ADDITIONAL INFORMATION

If more than one screen,
show locations of each on sketch.