

Pearl River
 W 2047
 10-19-81

MISSISSIPPI
 BOARD OF WATER COMMISSIONERS
 416 North State Street
 Jackson, Mississippi 39201

WATER WELL DRILLERS LOG

10-19-19
 date well completed

81 Woodwell Dr.
 firm name

Pearl River
 county well located

| LANDOWNER: <u>Musell Brown</u> | description of formations encountered | from | to |
|---|---------------------------------------|-------------|------------|
| <u> Hwy 11 - north</u> | | | |
| <u> Pecoyune ms.</u> (mailing address) | <u>Gravel</u> | <u>65</u> | <u>72</u> |
| | <u>Clay - Silt</u> | <u>72</u> | <u>385</u> |
| | <u>Sd</u> | <u>38.5</u> | <u>410</u> |

WELL LOCATION:
 sec. 13 T 6 N R 18 E
2 miles W IN IN of Pearl River
 (distance) (direction) (nearest town)

WELL PURPOSE: Water Pump
 (home, irrigation, municipal, industrial)

- WELL COMPLETION DATA:
- (1) diameter (inches) 4" x 2"
 - (2) total depth (feet) 410
 - (3) static water level (feet) 30 ^{below} _{above} top of ground.
 - (4) casing PVC 400
 (material) (depth)
2x4 If telescope see back.
 (size)
 - (5) screen 10' -
 (length) (depth to top)
2" Stainless Steel
 (size) (material)
 - (6) pump 1/2 20
 (HP) (yield gpm)
Elec.
 (type power)
 - (7) electric log NO
 (yes or no)
N/A
 (organization running log)
 - (8) how well bottom plugged BWV

DRILLERS REMARKS:


DEPT OF NATURAL RESOURCES
 BUREAU OF LAND & WATER RESOURCES
 NOV 30 1981
 RECEIVED

If well telescopes please sketch and show depths.

GROUND LEVEL

200 feet
4" Sch. 40 PVC

10 feet
200"
3" S.S. - 10 slot
3" Sch. 40 PVC
Barn

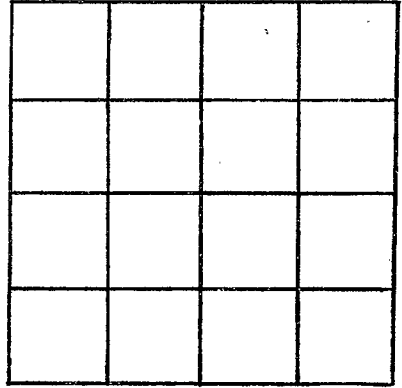

SECTION B

Please indicate well location X.

ADDITIONAL INFORMATION

If more than one screen, show locations of each on sketch.