

MISSISSIPPI DEPARTMENT OF NATURAL RESOURCES

Bureau of Land and Water Resources

Southport Mall

P.O. Box 10631

Jackson, Mississippi 39209

WATER WELL DRILLERS LOG

Paul River
W 2048

Nov 17 1981 Walker Welding Repair Shop Paul River
date well completed firm name county well located

LANDOWNER: Henry Hunt
picayune miss
(mailing address)

description of formations encountered	from	to
<u>White Chalk</u>	<u>0</u>	<u>12</u>
<u>limestone</u>	<u>12</u>	<u>36</u>
<u>Coarse white sand</u>	<u>36</u>	<u>63</u>
<u>fine pebbles</u>	<u>63</u>	<u>65</u>

WELL LOCATION:
sec 277 R 17
11 miles S picayune
(distance) (direction) (nearest town)

WELL PURPOSE: Drill
(home, irrigation, municipal, industrial)

WELL COMPLETION DATA:

(1) diameter (inches) 2"

(2) total depth (feet) 65'

(3) static water level (feet) 32 below above top of ground.

(4) casing PVC, 65'
(material) (depth)
(size) if telescope see back.

(5) screen 10', 55'
(length) (depth to top)
12, PVC
(size) (material)

(6) pump 1, 8
(HP) (yield gpm)
Elec
(type power)

(7) electric log (yes or no) _____
(organization running log) _____

DEPT OF NATURAL RESOURCES
BUREAU OF LAND & WATER RESOURCES

NO. 23 1981


RECEIVED

(8) how well bottom plugged sand
shack

DRILLERS REMARKS: _____

If well telescopes please sketch and show depths.

GROUND LEVEL

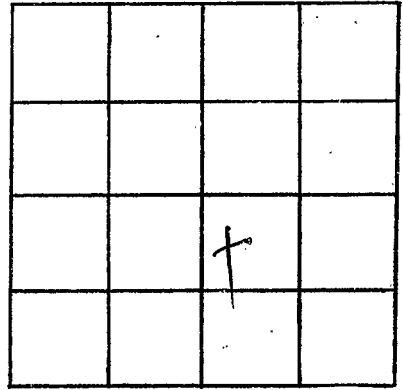

SECTION _____

Please indicate well location X.

ADDITIONAL INFORMATION

If more than one screen,
show locations of each on sketch.