

Pearl River
W 2049

MISSISSIPPI
BOARD OF WATER COMMISSIONERS
416 North State Street
Jackson, Mississippi 39201

WATER WELL DRILLERS LOG

12-16 1981 Penton Well Serv Pearl River
date well completed firm name county well located

LANDOWNER: <u>Victor Henley</u>	description of formations encountered	from	to
<u>Picayune MS.</u> (mailing address)	<u>Surface Clay</u>	<u>0</u>	<u>10</u>
	<u>Sand</u>	<u>10</u>	<u>27</u>
	<u>Clay</u>	<u>27</u>	<u>300</u>
	<u>Sand</u>	<u>300</u>	<u>348</u>
WELL LOCATION:			
sec. <u>2</u> T. <u>6</u> N. R. <u>17</u> E S. W.			
<u>0</u> miles <u>North</u> of <u>Picayune</u> (distance) (direction) (nearest town)			
WELL PURPOSE: <u>Home</u> (home, irrigation, municipal, industrial)			
WELL COMPLETION DATA:			
(1) diameter (inches) <u>2</u>			
(2) total depth (feet) <u>348</u>			
(3) static water level (feet) <u>26</u> below top of ground.			
(4) casing <u>PVC</u> , <u>338</u> , (material) (depth)			
<u>2</u> if telescope see back. (size)			
(5) screen <u>10'</u> , <u>338</u> (length) (depth to top)			
<u>2</u> , <u>PVC</u> (size) (material)			
(6) pump <u>1/2</u> , <u>10</u> (HP) (yield gpm)			
<u>Elec</u> (type power)			
(7) electric log <u>NO</u> (yes or no)			
(organization running log)			
(8) how well bottom plugged <u>BW Valve</u>			
DRILLERS REMARKS:			


DEPT. OF NATURAL RESOURCES
BUREAU OF LAND & WATER RESOURCES

JAN 21 1982

RECEIVED

If well telescopes please sketch and show depths.

GROUND LEVEL

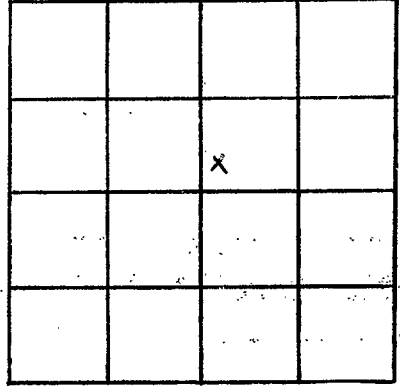

SECTION 2

Please indicate well location X.

ADDITIONAL INFORMATION

If more than one screen, show locations of each on sketch.