

MISSISSIPPI DEPARTMENT OF NATURAL RESOURCES

Bureau of Land and Water Resources

Southport Mall

P.O. Box 10631

Jackson, Mississippi 39209

WATER WELL DRILLERS LOG

Paul River
W 2050

Dec 10 1981 Walker Welding Paul River
 date well completed firm name county well located

LANDOWNER: <u>John M. Mather</u>	description of formations encountered	from	to
(mailing address)			
<u>Picayune Miss</u>			
<u>Shady Lake East</u>	<u>Heavy shale</u>	<u>0</u>	<u>15</u>
	<u>and peat ground</u>	<u>15</u>	<u>45</u>

WELL LOCATION:
 sec 36 T 6 N R 17 E
 S W
8 miles W Picayune
 (distance) (direction) (nearest town)

WELL PURPOSE: Home
 (home, irrigation, municipal, industrial)

- WELL COMPLETION DATA:
- (1) diameter (inches) 2 1/2"
 - (2) total depth (feet) 45'
 - (3) static water level (feet) 10 below top of ground.
 - (4) casing PVC, 45'
 (material) (depth)
 (size) if telescope see back.
 - (5) screen 10, 35'
 (length) (depth to top)
15, PVC slat
 (size) (material)
 - (6) pump no
 (HP) (yield gpm)
 (type power)
 - (7) electric log (yes or no)
 (organization running log)
 - (8) how well bottom plugged and
shut

DRILLERS REMARKS:


DEPT. OF NATURAL RESOURCES
 BUREAU OF LAND & WATER RESOURCES

JAN 8 - 1982

RECEIVED

If well telescopes please sketch and show depths.

GROUND LEVEL

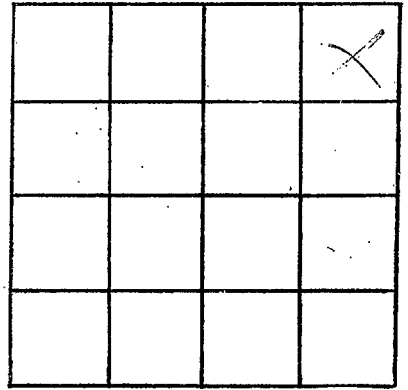

SECTION _____

Please indicate well location X.

ADDITIONAL INFORMATION

A series of 20 horizontal lines for entering additional information, starting below the 'ADDITIONAL INFORMATION' header.

REVISED
 82 JAN 8 AM 8:41

If more than one screen, show locations of each on sketch.