

MISSISSIPPI DEPARTMENT OF NATURAL RESOURCES

Bureau of Land and Water Resources

Southport Mall

P.O. Box 10631

Jackson, Mississippi 39209

WATER WELL DRILLERS LOG

Pearl River
W 2051

3-1-82 19
date well completed

Walton Welding
firm name

Bell River
county well located

LANDOWNER: Damon
Constructor Co

description of formations encountered	from	to

1708 East Canal
to search (mailing address)
Miss

<u>Heavy shell</u>	<u>6</u>	<u>14</u>
<u>Gravelly shell</u>	<u>14</u>	<u>36</u>
<u>Gravel</u>		

WELL LOCATION:
sec. 13 T. 5 N. R. 17 W.
City of Pearman
(distance) miles (direction) of (nearest town)

WELL PURPOSE:
(home, irrigation, municipal, industrial)

WELL COMPLETION DATA:

- (1) diameter (inches) 2"
- (2) total depth (feet) 36
- (3) static water level (feet) 14 below above top of ground.
- (4) casing PVC, 26'
(material) (depth)
(size) If telescope see back.
- (5) screen 10, 26'
(length) (depth to top)
12, Pvc slotted
(size) (material)
- (6) pump no
(HP) (yield gpm)
(type power)
- (7) electric log (yes or no)
- (organization running log)
- (8) how well bottom plugged Sand
shank

DRILLERS REMARKS:


DEPT. OF NATURAL RESOURCES
BUREAU OF LAND & WATER RESOURCES

APR 6 1982

RECEIVED

If well telescopes please sketch and show depths.

GROUND LEVEL

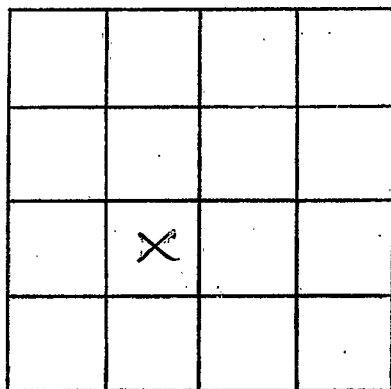

SECTION _____

Please indicate well location X.

ADDITIONAL INFORMATION

If more than one screen, show locations of each on sketch.