

Pearl River
W 2054

MISSISSIPPI DEPARTMENT OF NATURAL RESOURCES
 Bureau of Land and Water Resources
 Southport Mall
 P.O. Box 10631
 Jackson, Mississippi 39209
WATER WELL DRILLERS LOG

5-28 ⁸² 19 POUNGEY WATER WELL DRILLING Pearl River
 date well completed firm name county well located

LANDOWNER: M.R. Bryant -
Mill Brook Estates
Cook Drive
 (mailing address)

WELL LOCATION:
 sec. 1 T. 6 N. R. 17 E.
3 miles N-E of Preayin
 (distance) (direction) (nearest town)

WELL PURPOSE: AC Heat
 (home, irrigation, municipal, industrial)

- WELL COMPLETION DATA:
- (1) diameter (inches) 2
 - (2) total depth (feet) 209
 - (3) static water level (feet) 41 below above top of ground
 - (4) casing Pvc 199
 (material) (depth)
2 if telescope see back. (size)
 - (5) screen 10 199
 (length) (depth to top)
2 Pvc
 (size) (material)
 - (6) pump 3/4 8
 (HP) (yield gpm)
230 AC
 (type power)
 - (7) electric log /
 (yes or no)
 (organization running log)
 - (8) how well bottom plugged Sealed


description of formations encountered	depth	
	from	to
<u>Top</u>	<u>0</u>	<u>6</u>
<u>sd</u>	<u>6</u>	<u>20</u>
<u>gravel</u>	<u>20</u>	<u>26</u>
<u>clay</u>	<u>26</u>	<u>41</u>
<u>slty gnts</u>	<u>41</u>	<u>142</u>
<u>clay</u>	<u>142</u>	<u>181</u>
<u>sd. Pan</u>	<u>181</u>	<u>193</u>
<u>Clay</u>	<u>193</u>	<u>209</u>

DRILLERS REMARKS:

DEPT. OF NATURAL RESOURCES
 BUREAU OF LAND & WATER RESOURCES
 DEPT. OF NATURAL RESOURCES
 BUREAU OF LAND & WATER RESOURCES
 JUN 1 1982
 RECEIVED
 RECEIVED

If well telescopes please sketch and show depths.

GROUND LEVEL

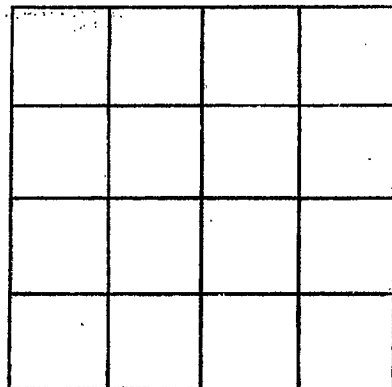

SECTION _____

Please indicate well location X.

ADDITIONAL INFORMATION

If more than one screen, show locations of each on sketch.