

MISSISSIPPI DEPARTMENT OF NATURAL RESOURCES

Bureau of Land and Water Resources

Southport Mall

P.O. Box 10631

Jackson, Mississippi 39209

WATER WELL DRILLERS LOG

BUD PENTON & SON

WATER WELL SERVICE

ROUTE BOX

CARRIERE, MS 39426

PHONE 798-5324

Pearl River
W
JOSS

4/17
date well completed

1982

Pearl River
county well located

LANDOWNER: Mr. John Brantly

description of formations encountered

from to

PO Box 1822 Liberty
Road.
(mailing address)

<u>white shale</u>	<u>0</u>	<u>15'</u>
<u>white sandstone</u>	<u>15</u>	<u>65'</u>
<u>Blue shale</u>	<u>65</u>	<u>231</u>
<u>Blue sand facis</u>	<u>231</u>	<u>347</u>

WELL LOCATION:

sec. 28 T. 6 N. R. 17 E
S W
4 miles NW of Pearl River
(distance) (direction) (nearest town)

WELL PURPOSE: Home
(home, irrigation, municipal, industrial)

WELL COMPLETION DATA:

- (1) diameter (inches) 2"
- (2) total depth (feet) 347
- (3) static water level (feet) 26 below above top of ground.
- (4) casing pvc 347
(material) (depth)
- if telescope see back.
(size)
- (5) screen 10 ft. 337
(length) (depth to top)
- 10 pvc
(size) (material)
- (6) pump 1/2 450
(HP) (yield gpm)
- Elect.
(type power)
- (7) electric log no
(yes or no)
- (organization running log)


(8) how well bottom plugged
Sand Shale

DRILLERS REMARKS:

DEPT. OF NATURAL RESOURCES
BUREAU OF LAND & WATER RESOURCES
JUL - 1 1982
RECEIVED

If well telescopes please sketch and show depths.

GROUND LEVEL

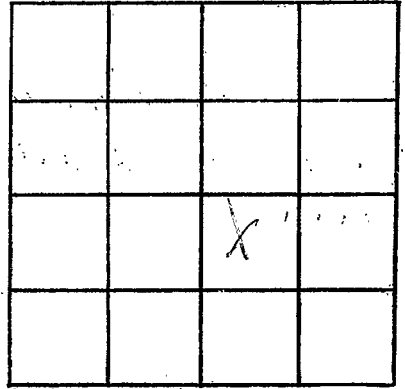

SECTION _____

Please indicate well location X.

ADDITIONAL INFORMATION

If more than one screen,
show locations of each on sketch.